


Per 25810
31049

T.9&10 S. R.32 E. W.M.

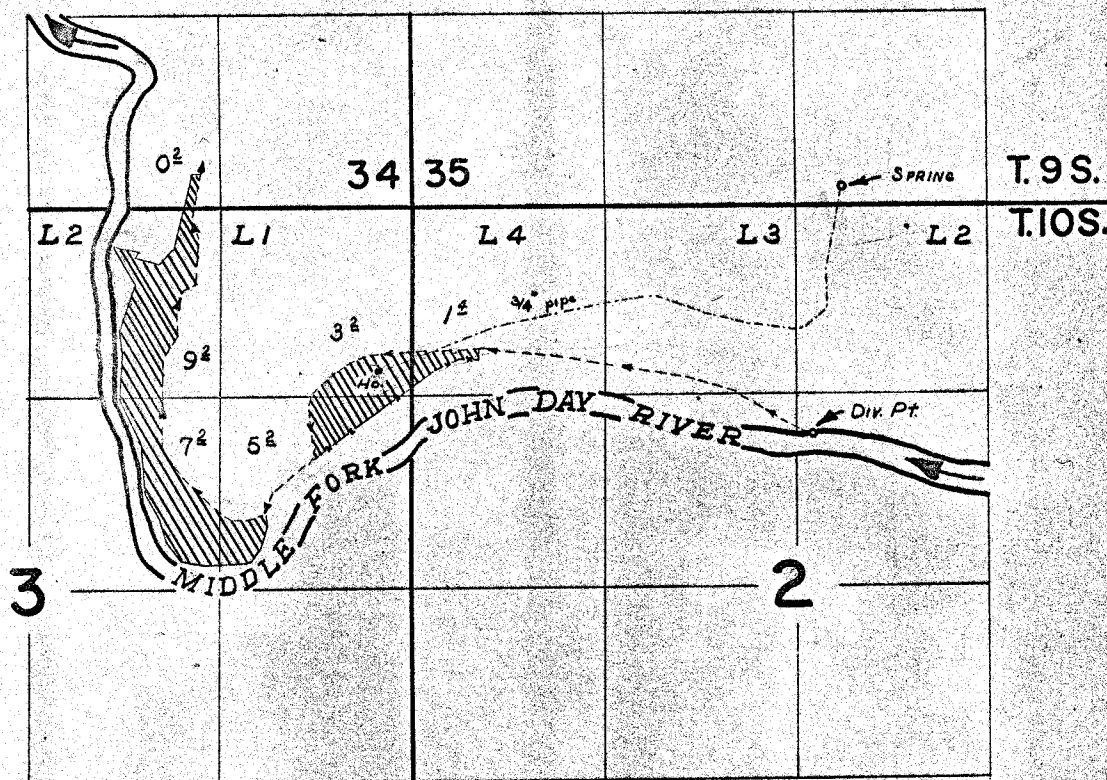

FINAL PROOF SURVEY
UNDER

file—32707 25810
Application No. 32668 Permit No. 25797...
IN NAME OF

GEORGE L. GIBBS

Surveyed Nov 13, 1962, by C.R. Baker.