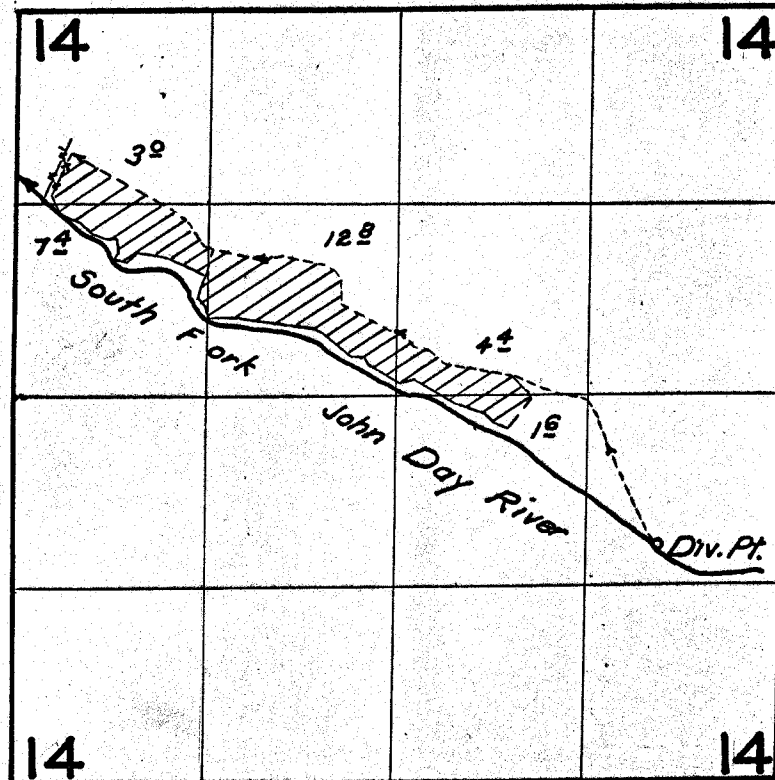


T.18S. R.28E.W.M.

**FINAL PROOF SURVEY**
UNDERApplication No. 37645 Permit No. 28066
IN NAME OFAbe RickmanSurveyed Nov 8 1962, by Carl R. Baker