


T 35 S R 2 WWM SEC 29

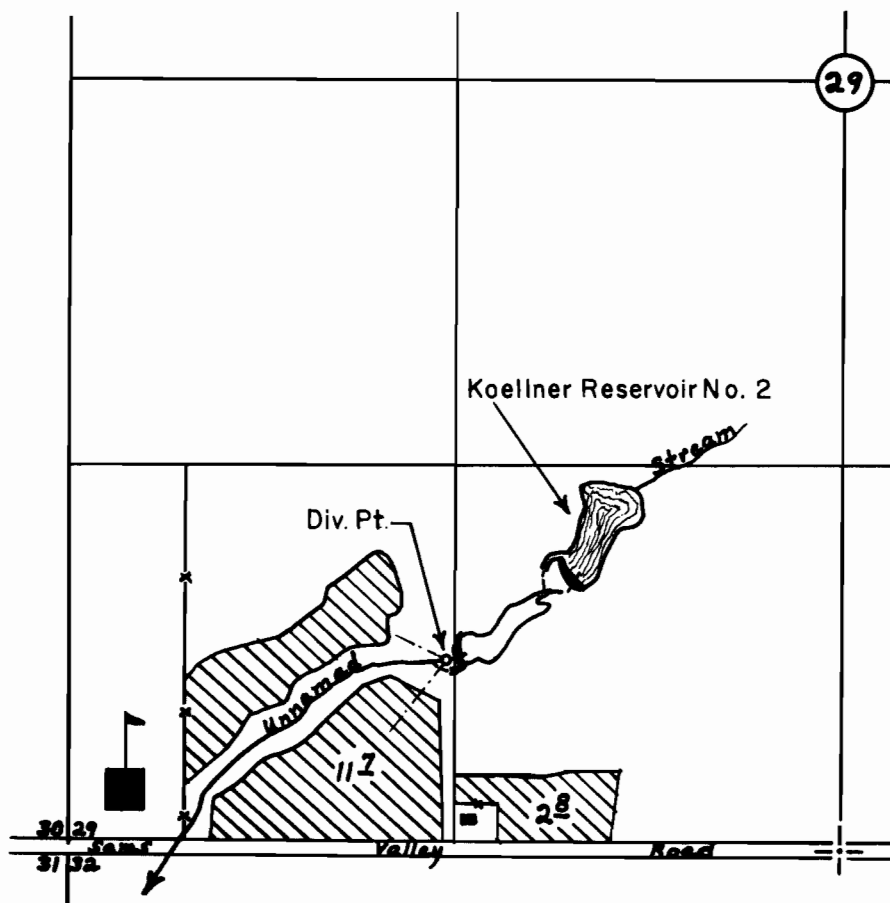

FINAL PROOF SURVEY UNDER

R-29034 R-1605
Application No. 29035 Permit No. 22842
IN NAME OF

Lester T. Conn

Surveyed Jan. 22, 1963, by D.C. Hendrix

Scale: 8" = 1 mile