


T. 40S. R. 4W.W.M.

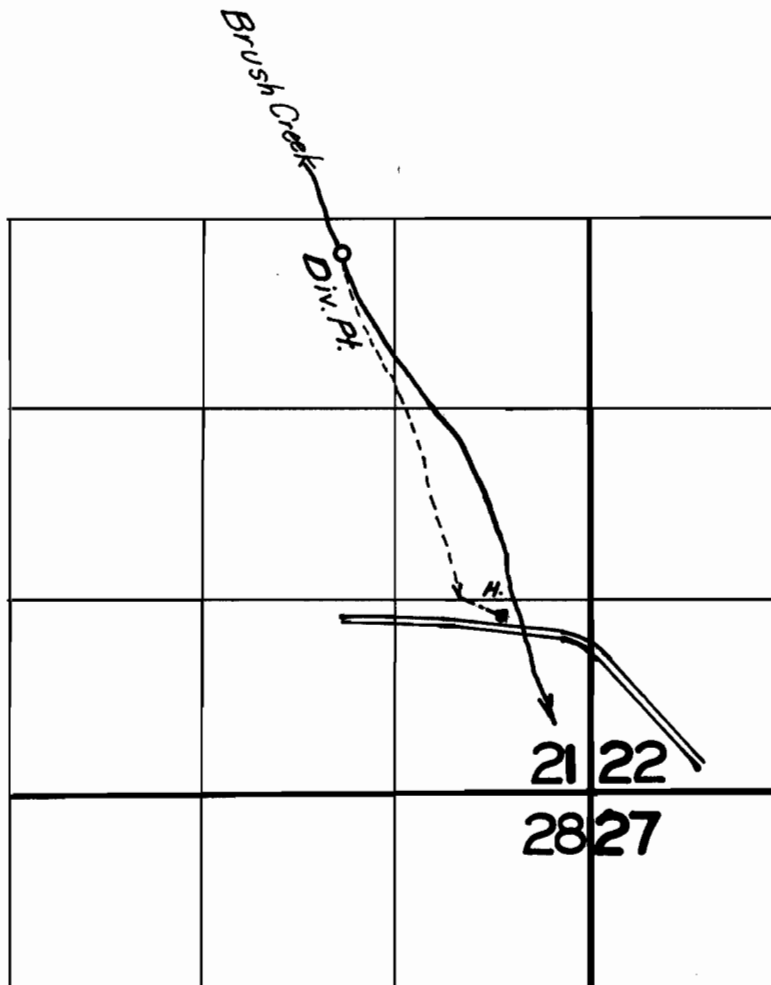

FINAL PROOF SURVEY
UNDER

Application No. 30854 Permit No. 24277
IN NAME OF

Truman Aubrey

Surveyed 18 April 1962, by Carl R. Baker