


TWP. 38S. R4W.W. M. SEC. 28

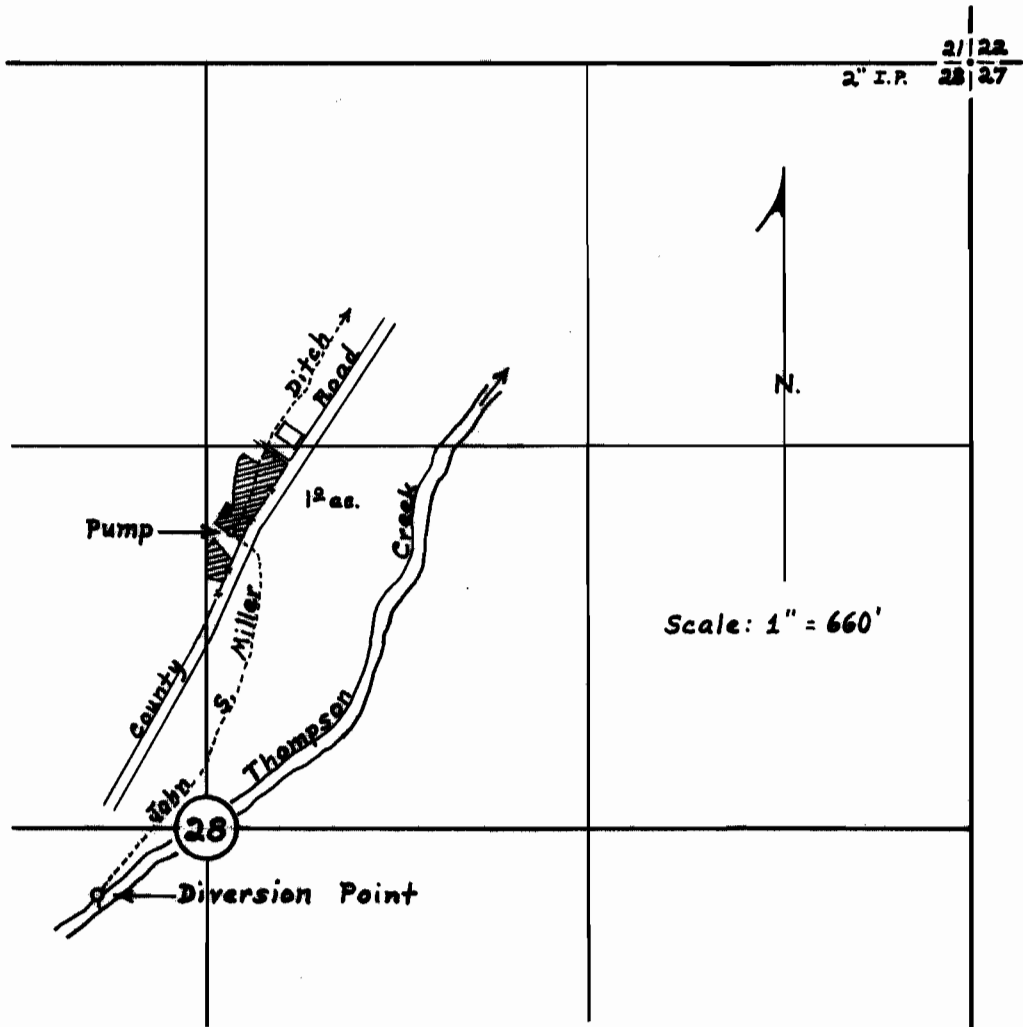

FINAL PROOF SURVEY
UNDER

Application No. 34030.. Permit No. 26836..
IN NAME OF

..... Nina N. Day

Surveyed Jan. 18..... 19.63, by D.C. Hendrix.....

[Handwritten notes and signatures]