


T. 10 S.R.13 E.W.M.

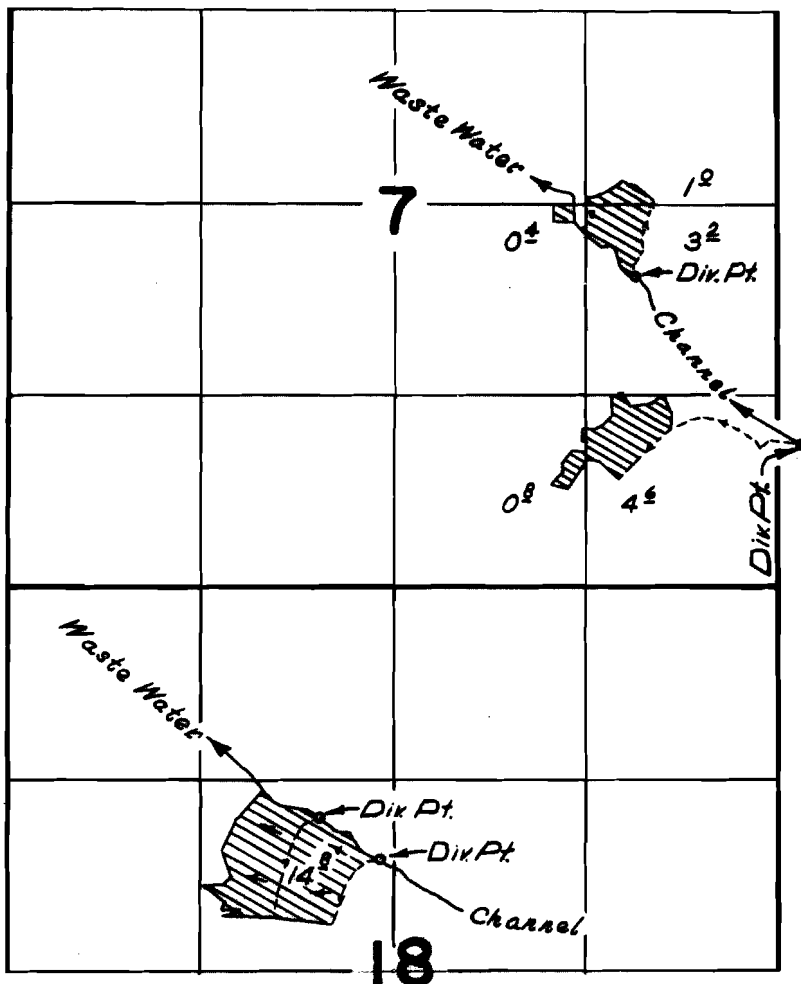

FINAL PROOF SURVEY UNDER

Application No. 334.28. Permit No. 26452.
IN NAME OF

.....JOHN L. CAMPBELL.....

Surveyed Oct. 20, 1962, by T.R. Lauer.....