


**RECEIVED**  
APR 22 1963  
**STATE ENGINEER**  
SALEM, OREGON

TWP 38 S R8 WWM

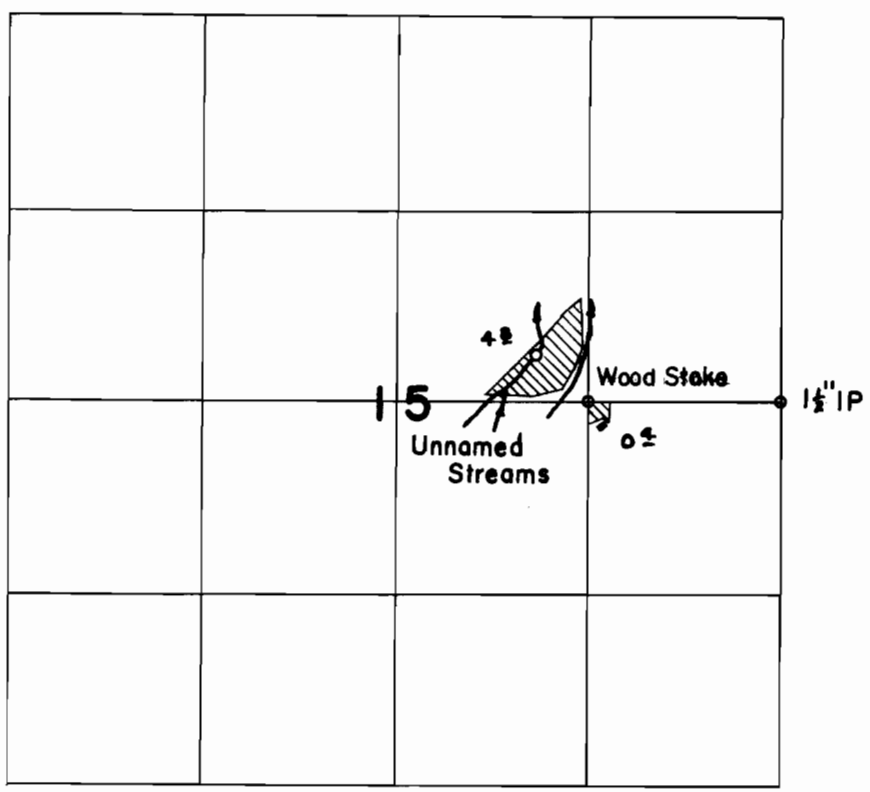

**FINAL PROOF SURVEY**  
UNDER

Application No. 32712..... Permit No. 25812.....  
IN NAME OF

.....Robert J. Lanfranco.....

Surveyed 6-1..... 1962., by R. Steimer.....