


T.36S. R.11E. W.M.

Sprague River well

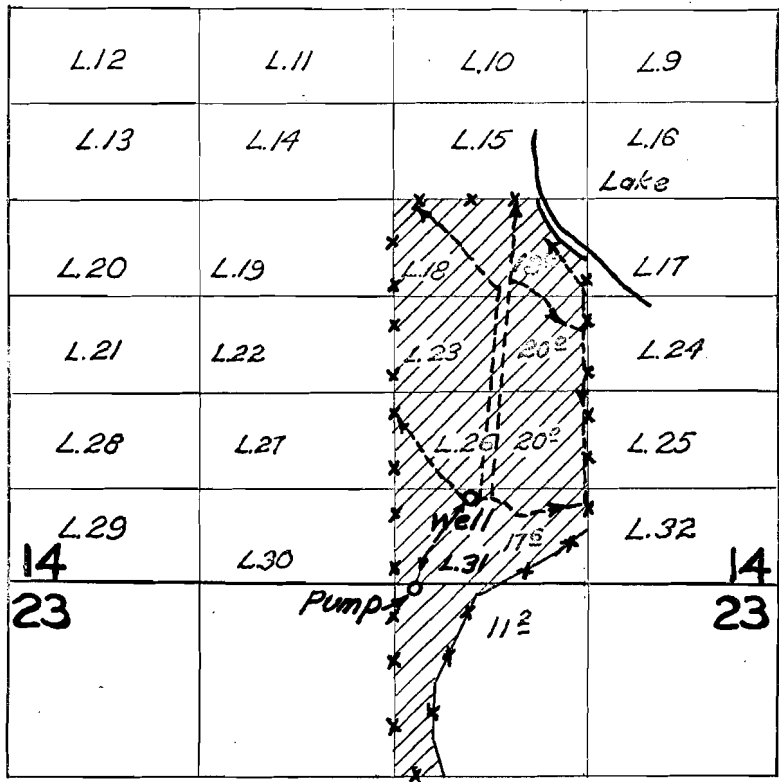

FINAL PROOF SURVEY
UNDER

Application No. G-1255 Permit No. G-1156
IN NAME OF

Edwin K. & Bonnie B. Vieira

Surveyed 20 Aug. 1962, by Carl R. Baker.