


T.39S. R.10E.W.M.

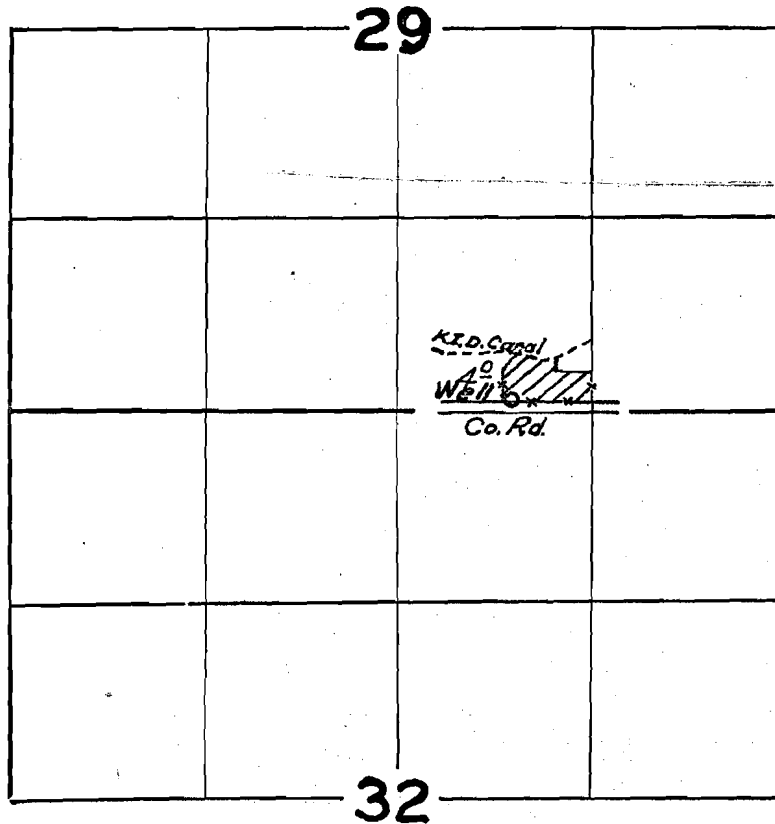

Just River wells

**FINAL PROOF SURVEY**  
UNDER

Application No. *G-1994*. Permit No. *G-1833*  
IN NAME OF

*.....Lester Z. & Frances H. Brookshire*

Surveyed *14 Aug...* 1962, by *Carl R. Baker...*