


14
31064
22823

T.34S.R.6E.W.M.

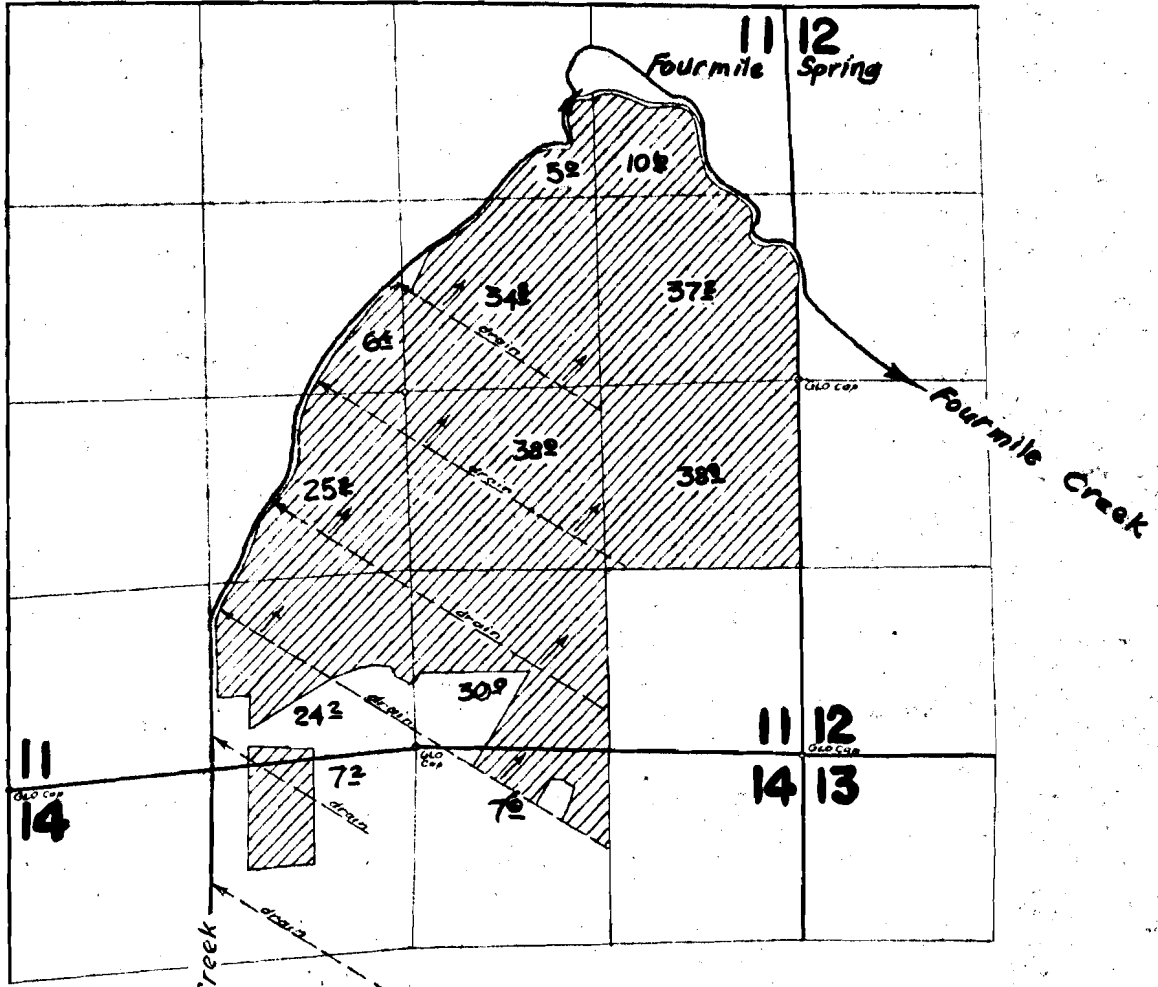

Cherry Creek & Mac.

FINAL PROOF SURVEY UNDER

Application No. 28909 Permit No. 22823
IN NAME OF
**FRED G., CECIL M., GRANT F. &
LOIS M. BROWN**

Surveyed August 20 1962, by *W. Jackson*