


26319
31065

T.32&33S. R.6&7 1/2 E.W.M.

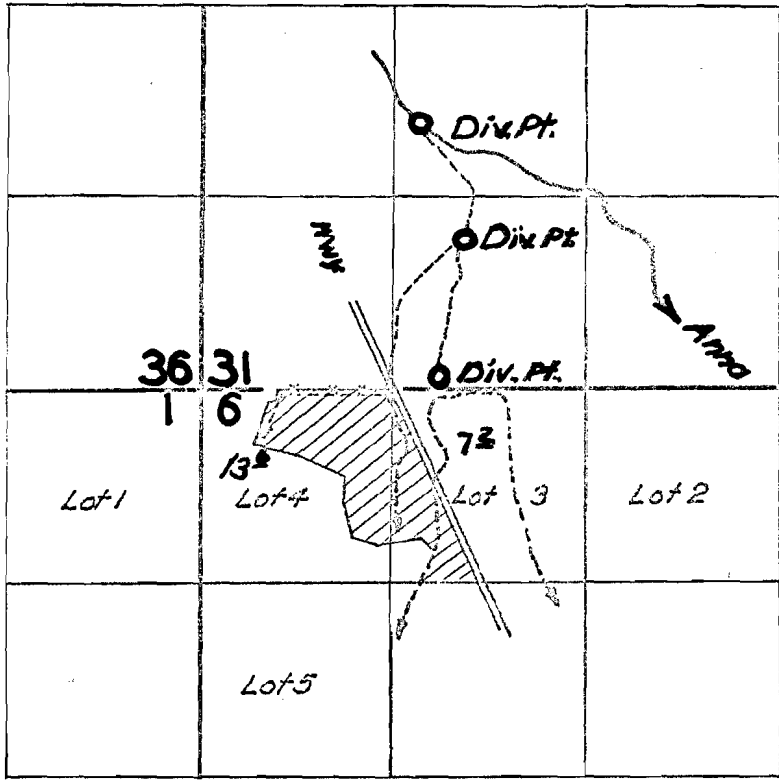

Anna Creek: nise.

FINAL PROOF SURVEY UNDER

Application No. 22125. Permit No. 26319
IN NAME OF

Elaine G. Kerns

Surveyed 21 August 1962, by Carl R. Baker