


26668
31066
33130

T.33&34S.R.7½E.W.M.

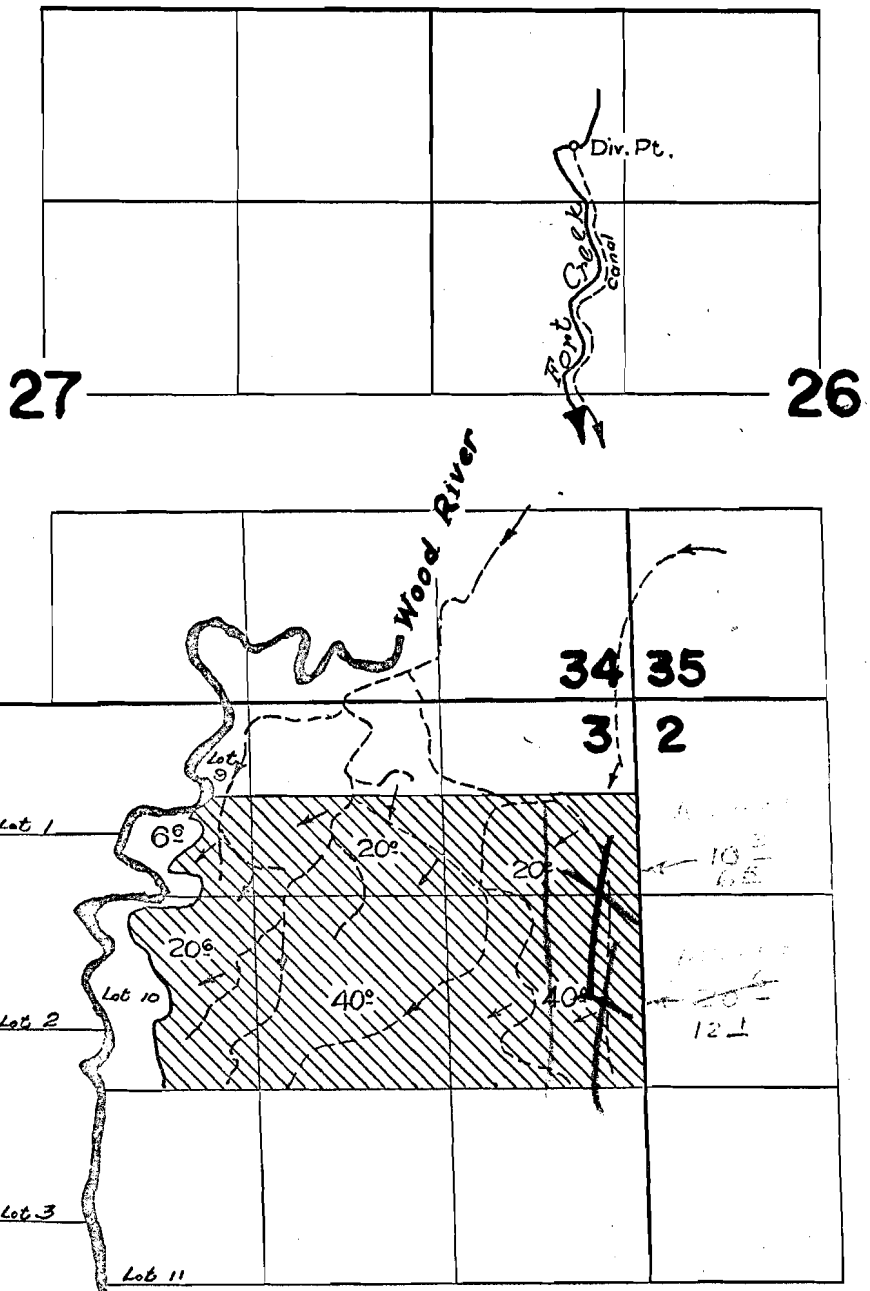

Crooked Cbk. & mead.

see map
29099

FINAL PROOF SURVEY UNDER

Application No. 33779 Permit No. 26668
IN NAME OF

J. L. & R. D. HELMS

Surveyed August 14 1962., by R. Johnson