


T.27S. R.15E.W.M.

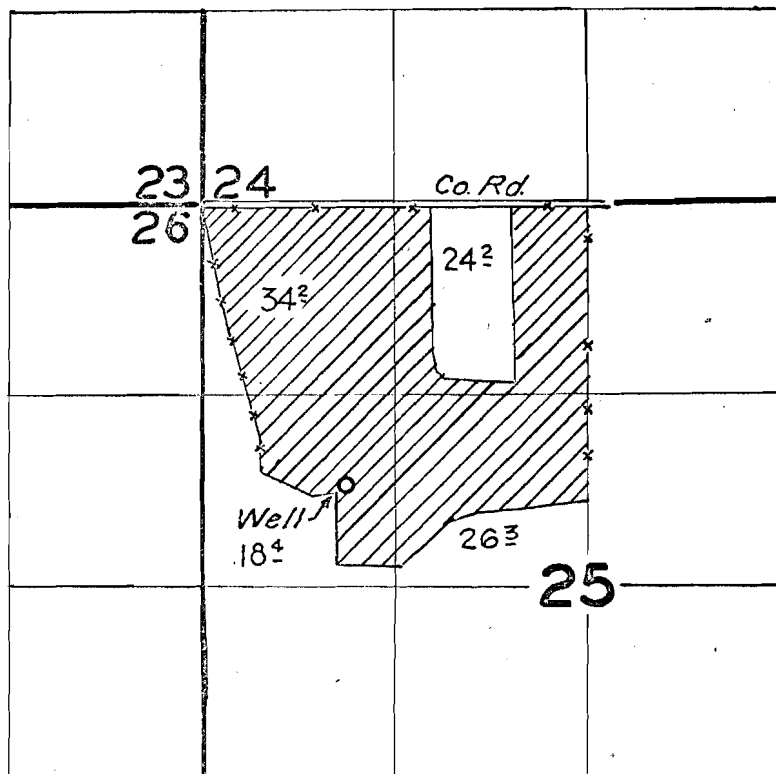

2
34.2
24.2
18.4
103.0

FINAL PROOF SURVEY
UNDER

Application No. U-765 Permit No. U-706
IN NAME OF

Herman Paul Koehler

Surveyed Sept. 13, 1962, by Carl R. Baker