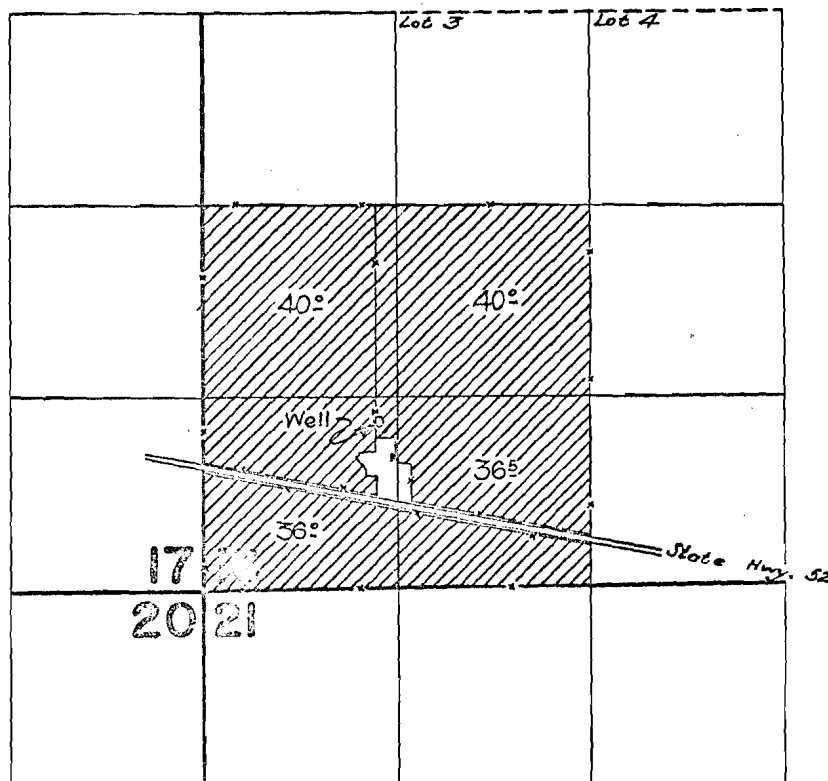


G-56

31069

T.34S.R.19E.W.M.

**FINAL PROOF SURVEY**
UNDERApplication No. G-154..... Permit No. G-56.....
IN NAME OF.....**HOWARD BEACHLER**.....Surveyed Sept. 15, 1962, by *Alfredson*