


31072  
T80B

# T.27S. R.17E.W.M.

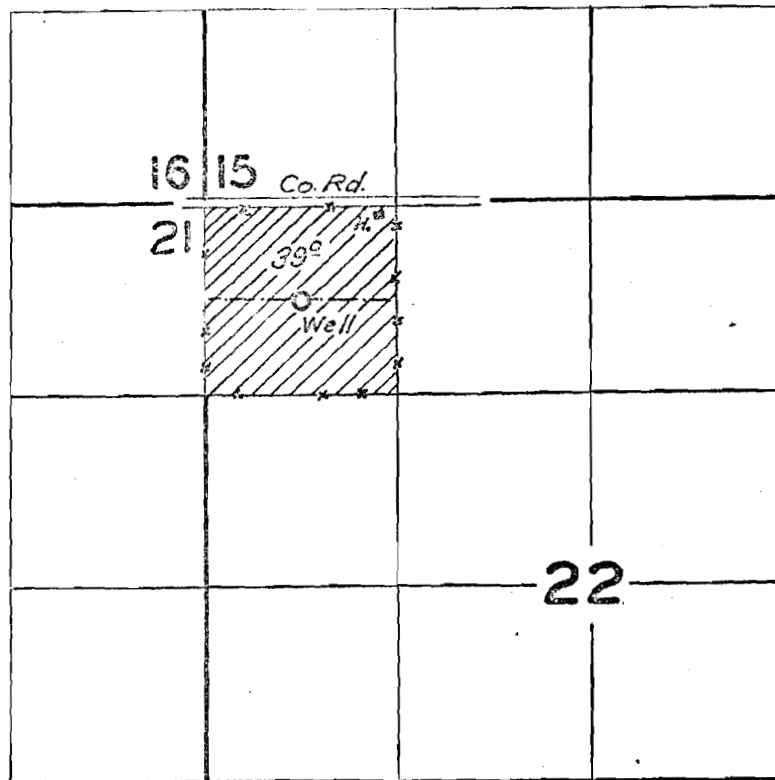

## FINAL PROOF SURVEY UNDER

Application No. *G-2190*. Permit No. *G-2017*.  
IN NAME OF

*M. Penn. Phillips Co.*

Surveyed *14. Sept. 1962*, by *Carl R. Baker*

✓  
1962-X