


T.19S.R.12W.W.M.

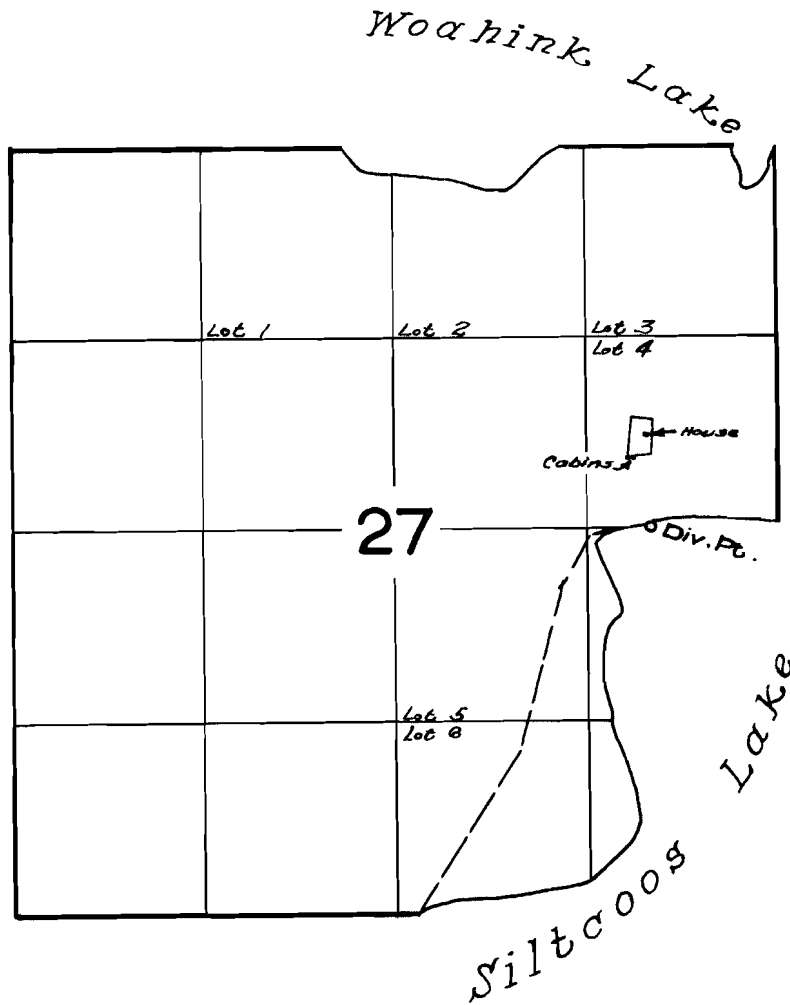

**FINAL PROOF SURVEY**  
UNDER

Application No. **32551** Permit No. **25704**  
IN NAME OF

**MARTIN CHRISTENSEN**

Surveyed May 7, 1962, by *A. Jackson*