


T.19S.R.12W.W.M.

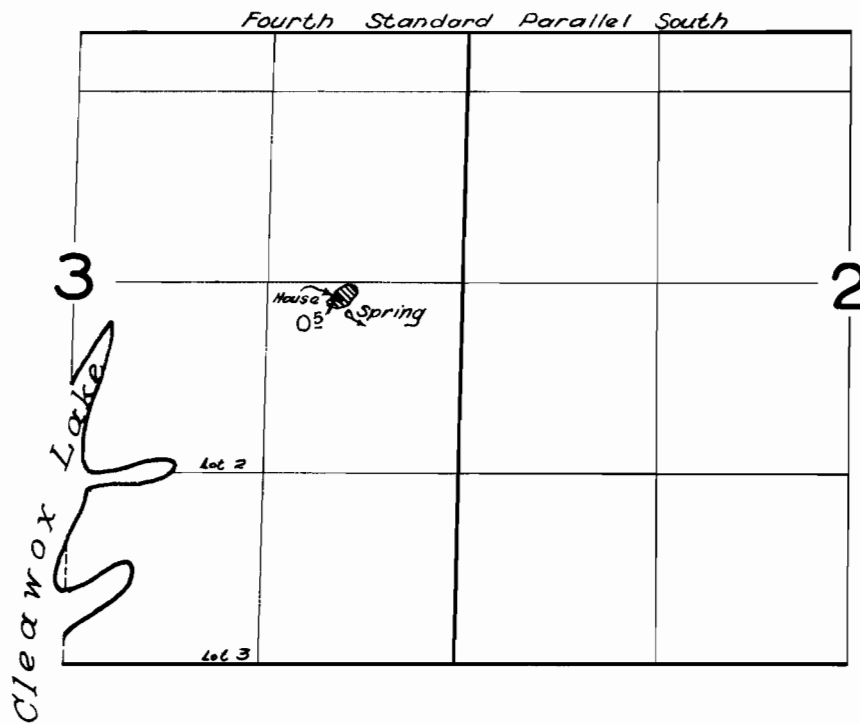

FINAL PROOF SURVEY
UNDER

Application No. **32599** Permit No. **25725**
IN NAME OF

R. C. BUSWELL

Surveyed May 9 1962, by *[Signature]*