


T.19S. R.12W. W.M.

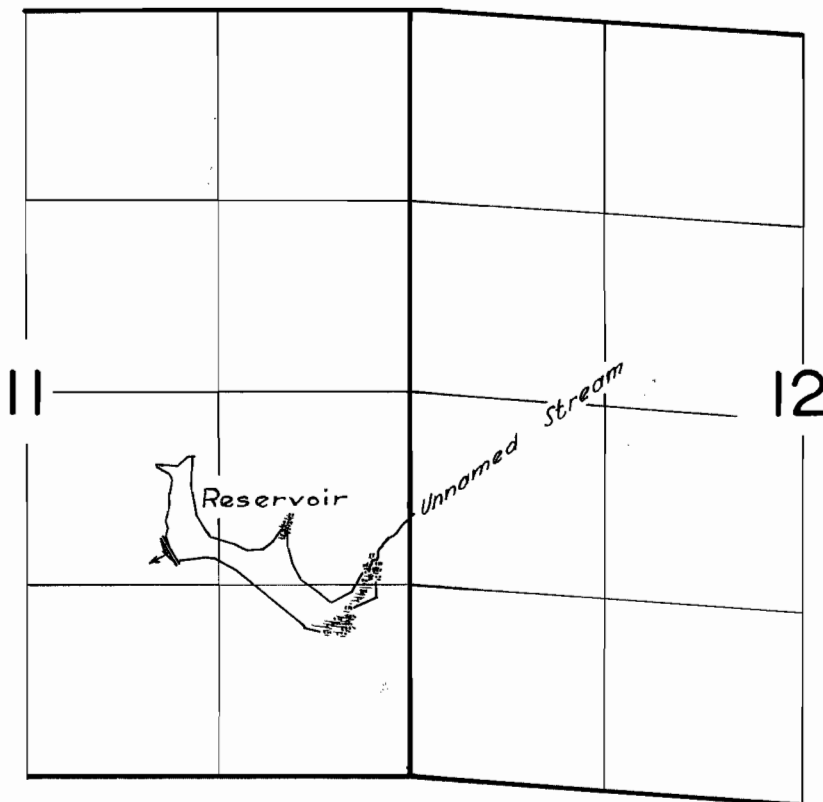

**FINAL PROOF SURVEY**  
UNDER

Application No. **R-33629** **33630** Permit No. **R-2685** **27632**  
IN NAME OF

**A. E. BARNUM**

Surveyed May 23 1962, by *R. Jackson*