


T.19S. R.12W. W.M.

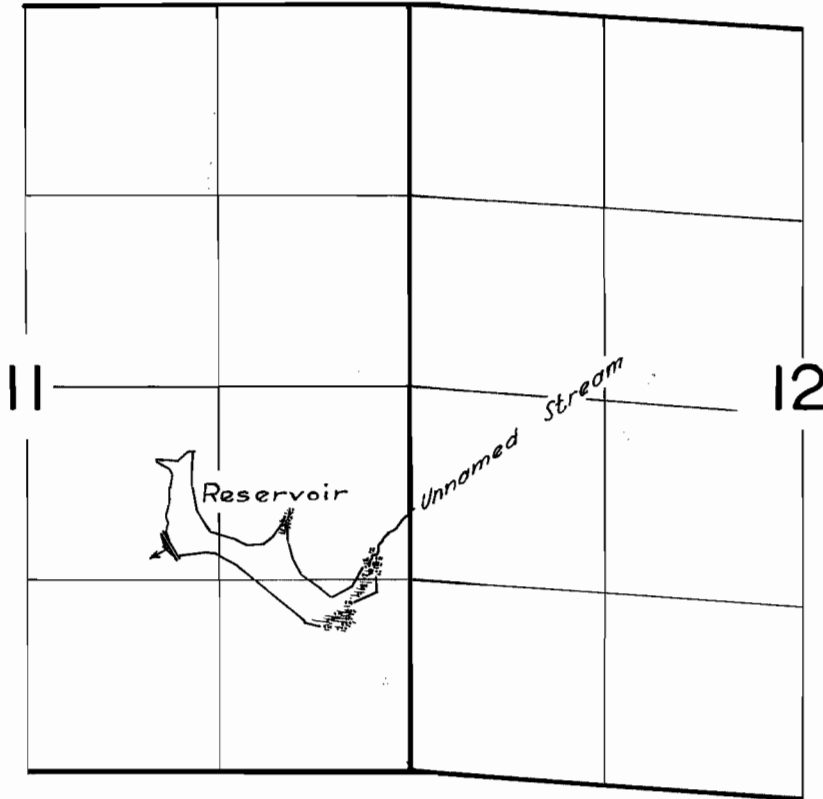

FINAL PROOF SURVEY
UNDER

Application No. **R-33629** **33630** Permit No. **R-2685** **27632**
IN NAME OF

A. E. BARNUM

Surveyed May 23 1962, by *R. Jackson*