


T. 11 S. R. 10 W. W.M.

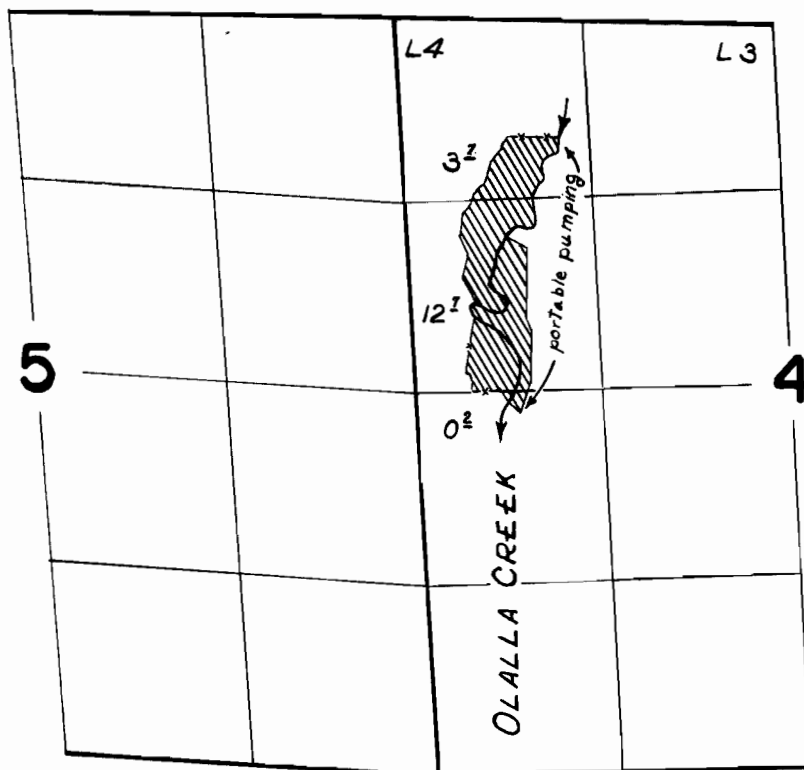

FINAL PROOF SURVEY
UNDER

Application No. 30998... Permit No. 24386...
IN NAME OF

JOHN H. DICKINSON

Surveyed *June 29, 1962*, by *C.R. Baker*.....