


T. 9 S.R. 10 W.W.M.

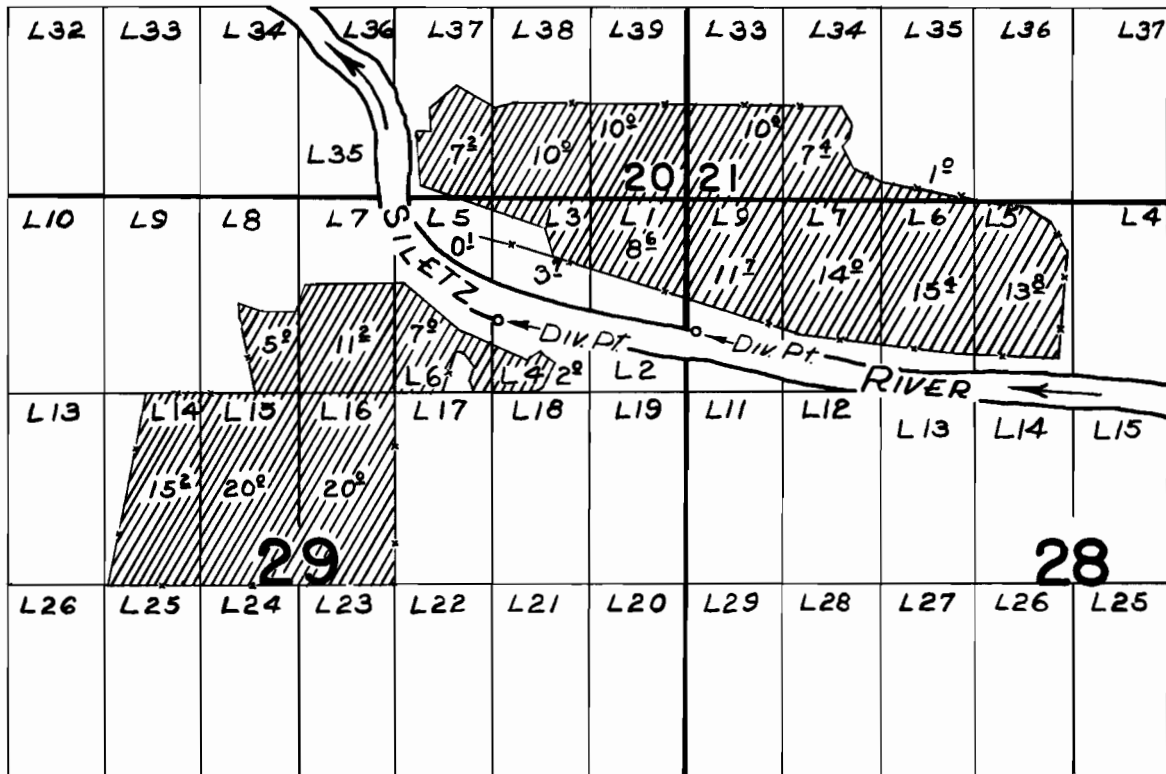

FINAL PROOF SURVEY UNDER

Application No. 31524. Permit No. 24863.
IN NAME OF

KIRK DESKINS RANCHES

Surveyed *JUNE 27 1962*, by *C.R. Baker*.