


T. 9 S.R. 11 W.W.M.

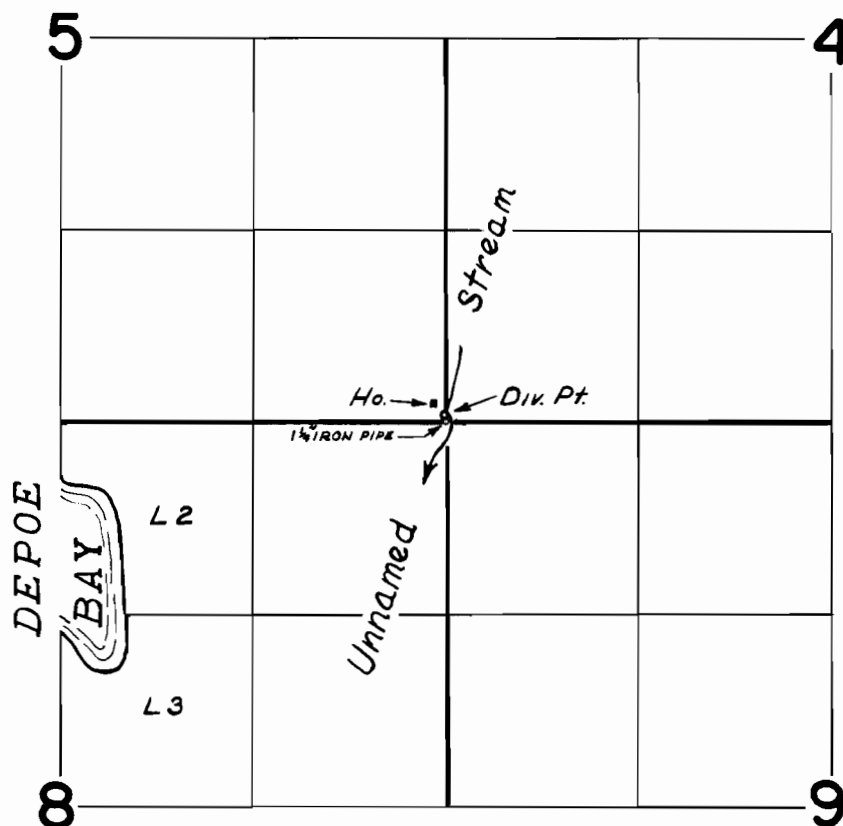

FINAL PROOF SURVEY
UNDER

Application No. 37376 Permit No. 27821...
IN NAME OF

LADELLE & BEULAH KAUFMAN

Surveyed June 27 1962, by C.R. Baker...