


T. 7 S.R. 11 W.W.M.

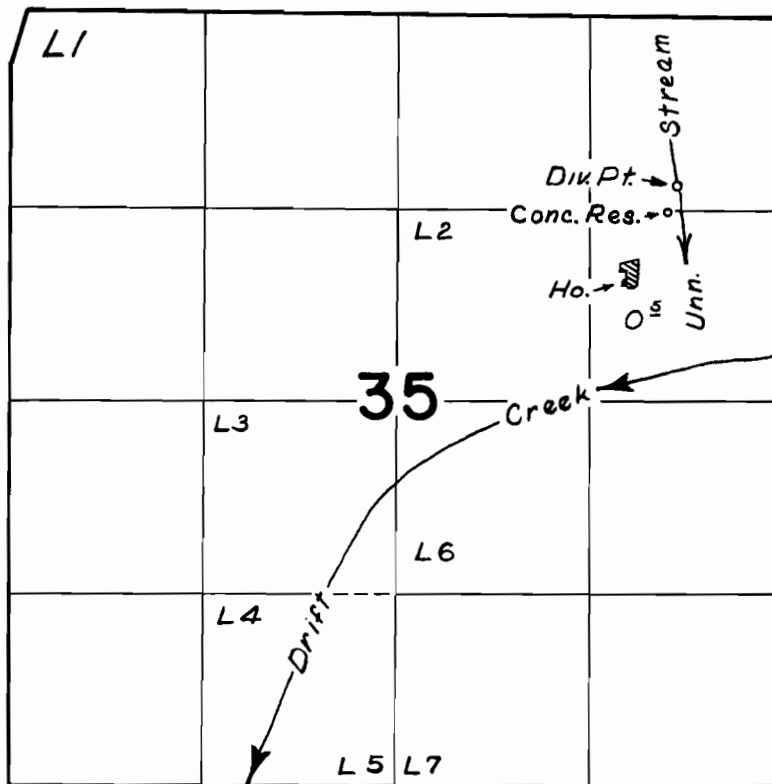

FINAL PROOF SURVEY UNDER

Application No. 37382... Permit No. 27825...
IN NAME OF

..... EDGAR C. PARMELE

Surveyed June 27, 1962, by C.R. Baker.....