


T. 13 S. R. 1 E. W. M.

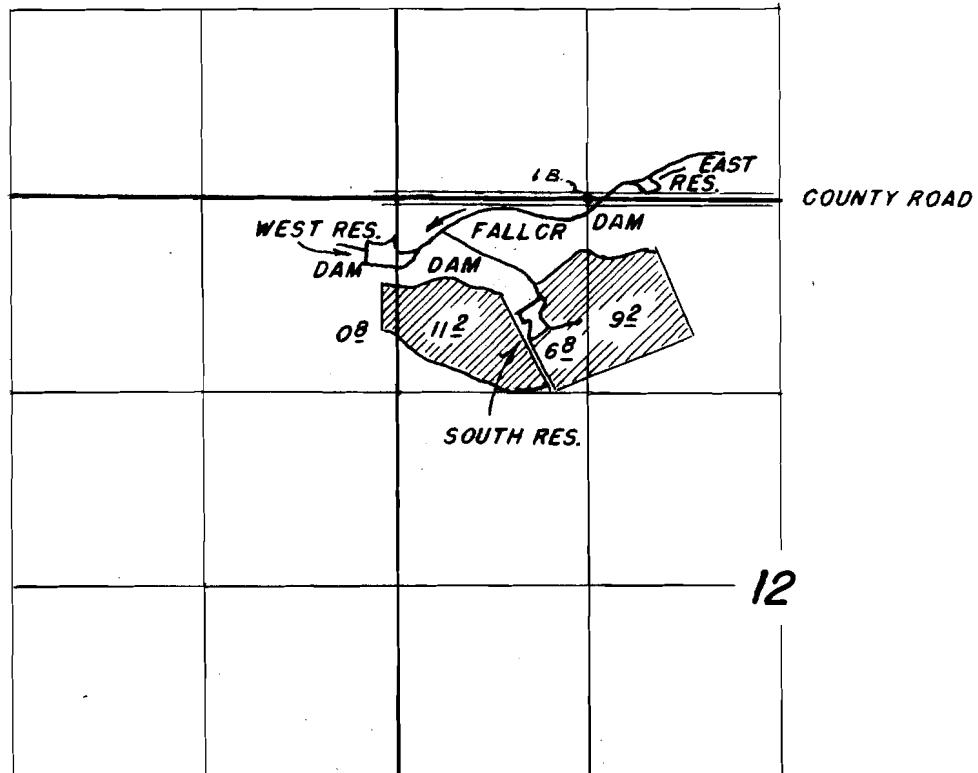

FINAL PROOF SURVEY
UNDER

Application No. ²⁶⁷⁰⁰ ~~R-26699~~ Permit No. ²⁰⁹⁰⁰ ~~R-1290~~
IN NAME OF

Martin & Martha Pickins

Surveyed Feb 6 19 63 by *Floyd L. Siegmund*