


T. 13 S. R. 1 E. W. M.

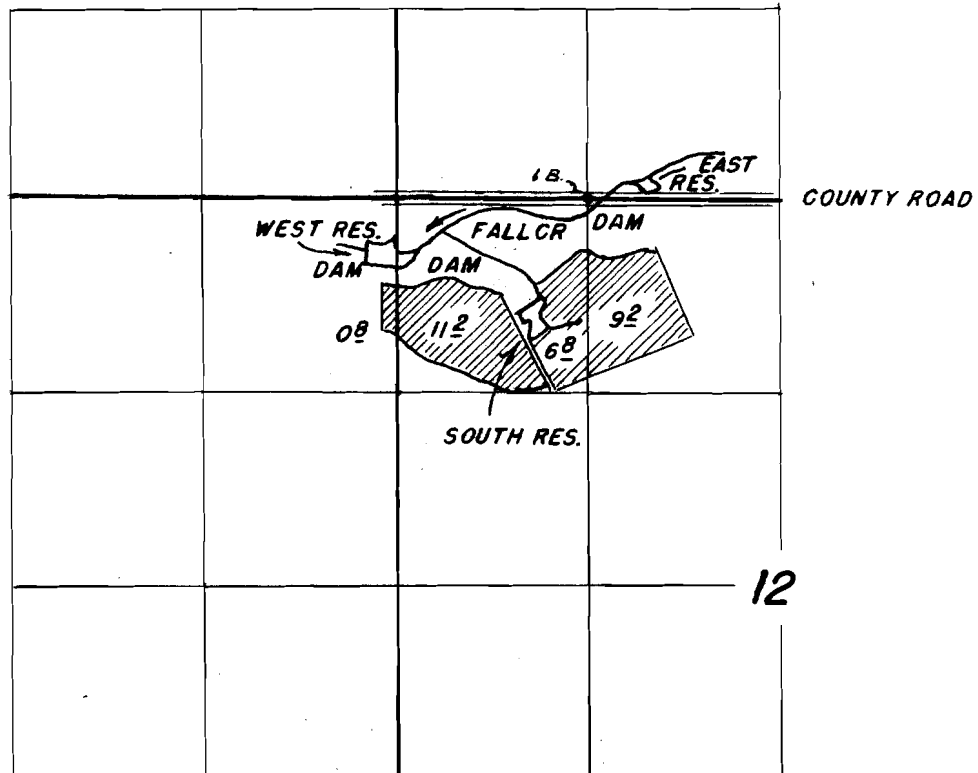

FINAL PROOF SURVEY
UNDER

Application No. 26700 Permit No. 20900
R-26699 R-1290
IN NAME OF

Martin & Martha Pickins

Surveyed Feb 6 19 63 by Floyd L. Siegmund