


# T.14 S.R. 39 E.W.M.

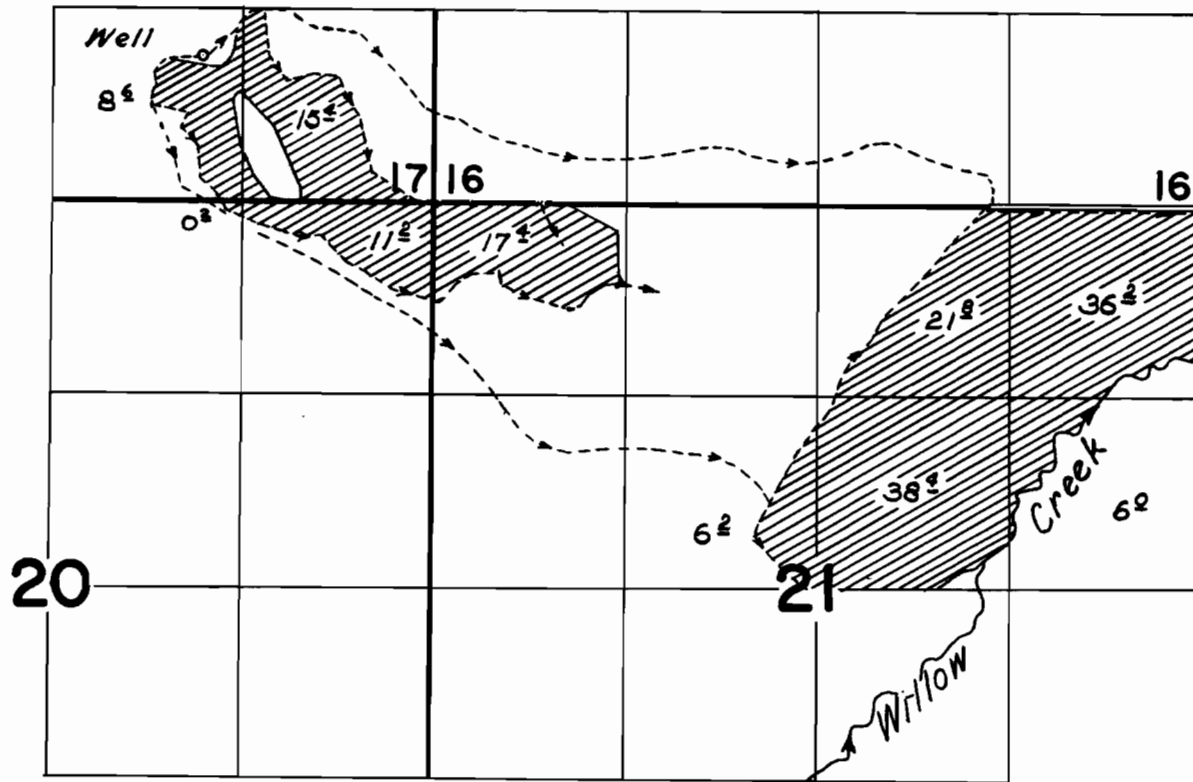

## FINAL PROOF SURVEY UNDER

Application No. *U-857* Permit No. *U-749*  
IN NAME OF

**R. A. DUNCAN**

Surveyed *July 13, 1962*, by *C.R. Baker*