


# T. 14 S. R. 39 E. W.M.

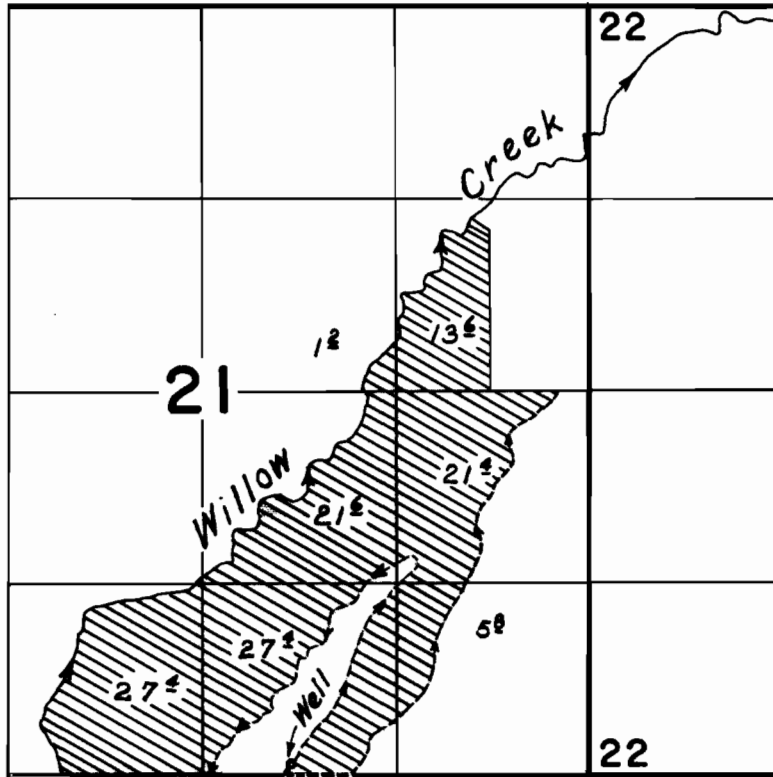

## FINAL PROOF SURVEY UNDER

Application No. *G-841* Permit No. *G-748*  
IN NAME OF

**MARY J. MOLTHAN**

Surveyed *July 14 1962*, by *C.R. Baker*