


T. 14 S. R. 39 E. W.M.

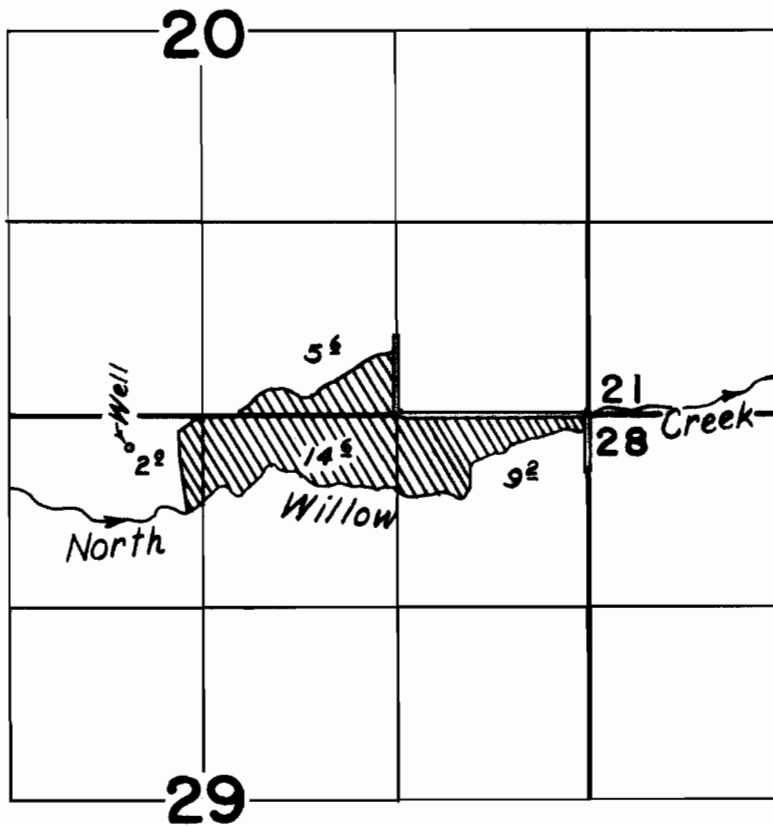

FINAL PROOF SURVEY UNDER

Application No. *G-932*. Permit No. *G-852*...
IN NAME OF

.....**JOHN MOLTHAN**.....

Surveyed *July 13, 1962*, by *C.R. Baker*...