


T. 18 S.R. 45 E.W.M.

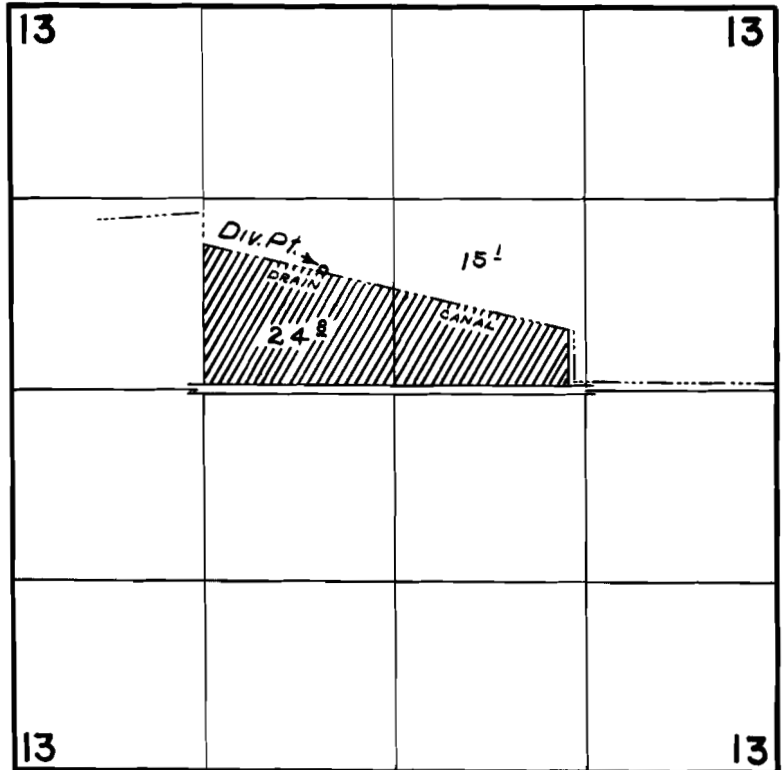

FINAL PROOF SURVEY UNDER

Application No. G-1615 Permit No. G-1509
IN NAME OF

CHARLES W. & CHRISTINE MOORE

Surveyed June 9, 1962, by C.R. Baker