


# T. 18 S.R. 45 E.W.M.

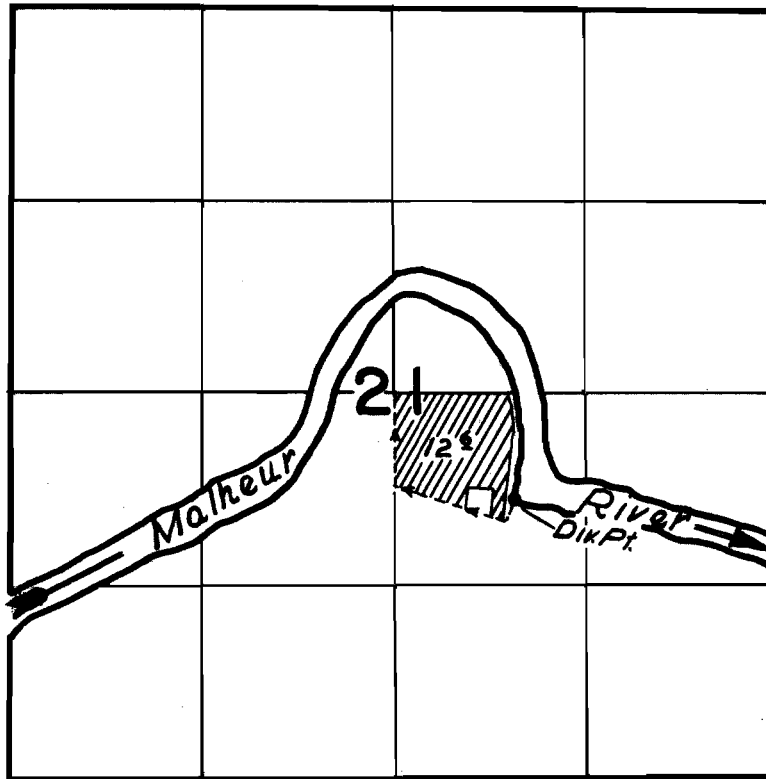

## FINAL PROOF SURVEY UNDER

Application No. 33011.... Permit No. 2612.3....  
IN NAME OF

.....CLAUDE SHEARER.....

Surveyed June 5, 1962, by C.R. Baker.....