


# T.9&10S.R.2W.W.M.

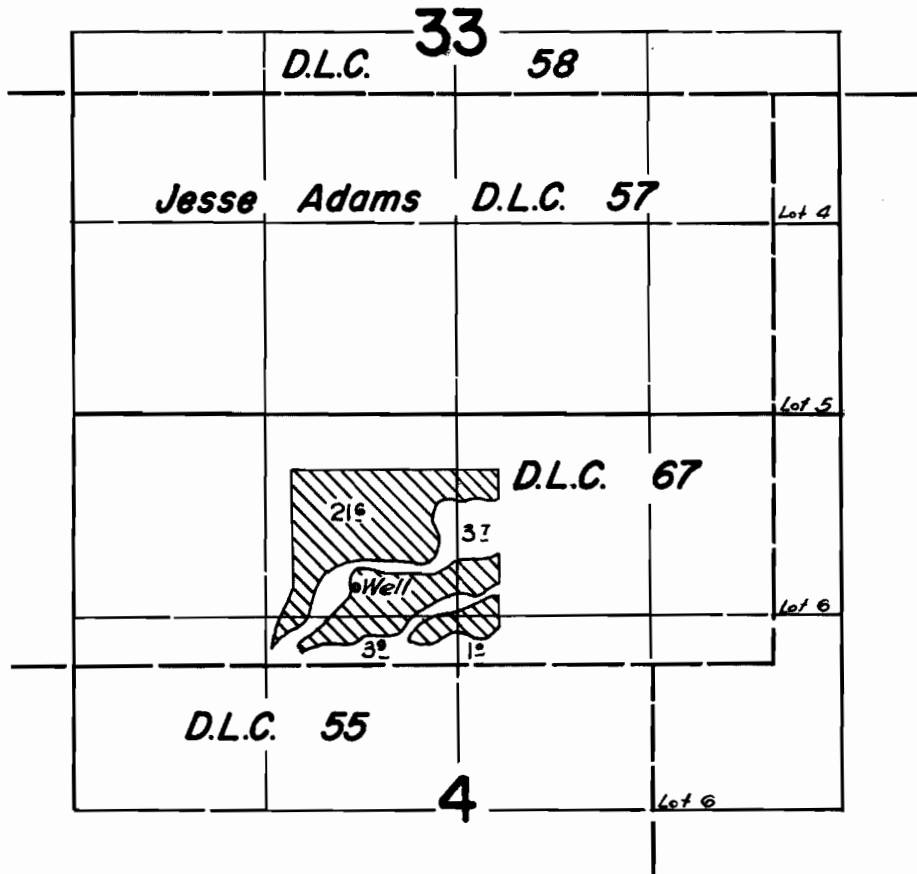

## FINAL PROOF SURVEY UNDER

Application No. G-1363. Permit No. G-1239.  
IN NAME OF

**GALE A. HART**

Surveyed June 22 1962, by *R. Jackson*