


T.10S.R.2W.W.M.

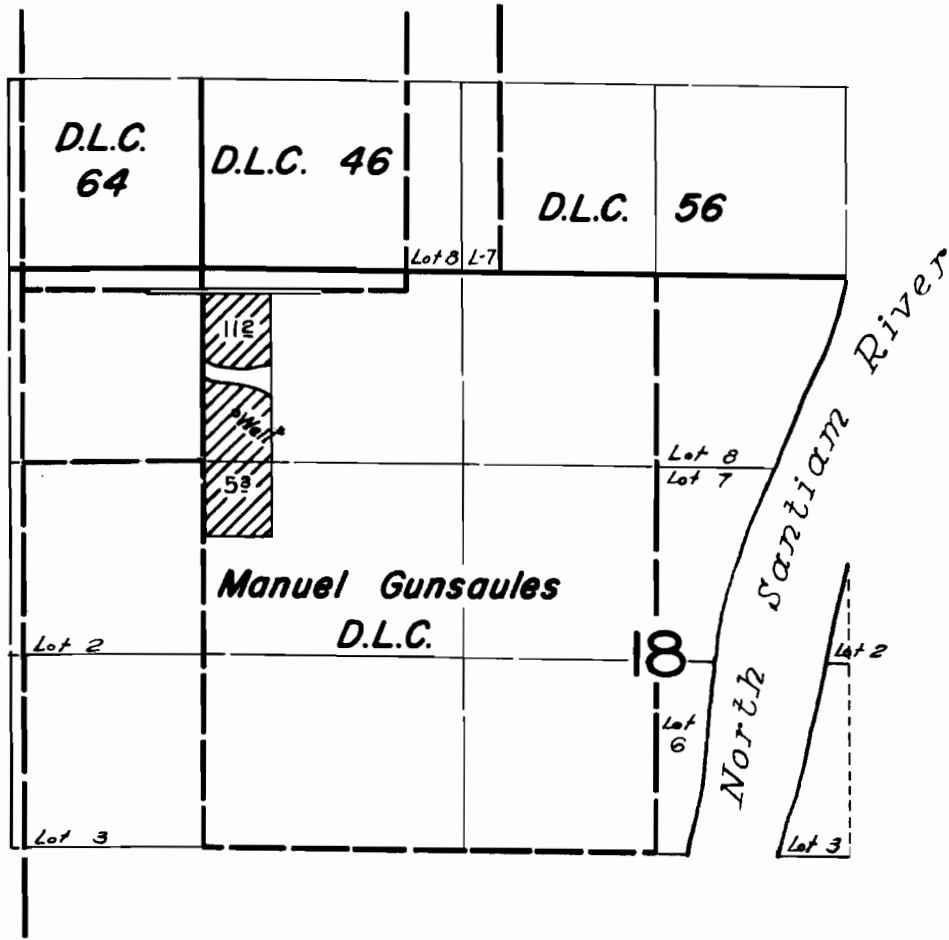

FINAL PROOF SURVEY UNDER

Application No. G-1470... Permit No. G-1349...
IN NAME OF

ROY D. TILLEY

Surveyed June 21, 1962, by *[Signature]*