


T.7S.R.1E.W.M.

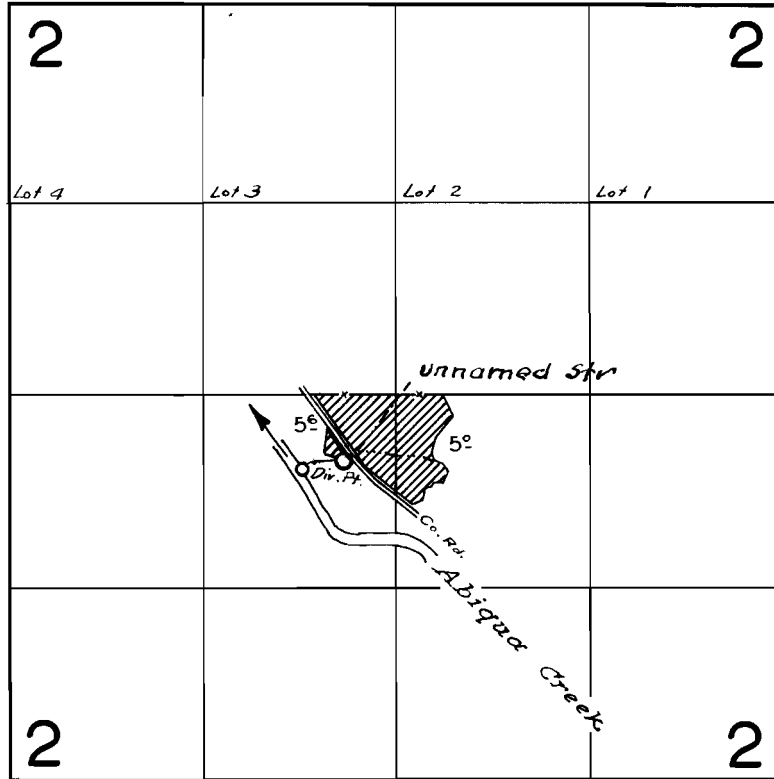

FINAL PROOF SURVEY UNDER

Application No. 32649... Permit No. 25749...
IN NAME OF

AAGE CLARK MOHR

Surveyed June 18 1962, by *R. Jackson*