


2

# T.IOS.R.2W.W.M.

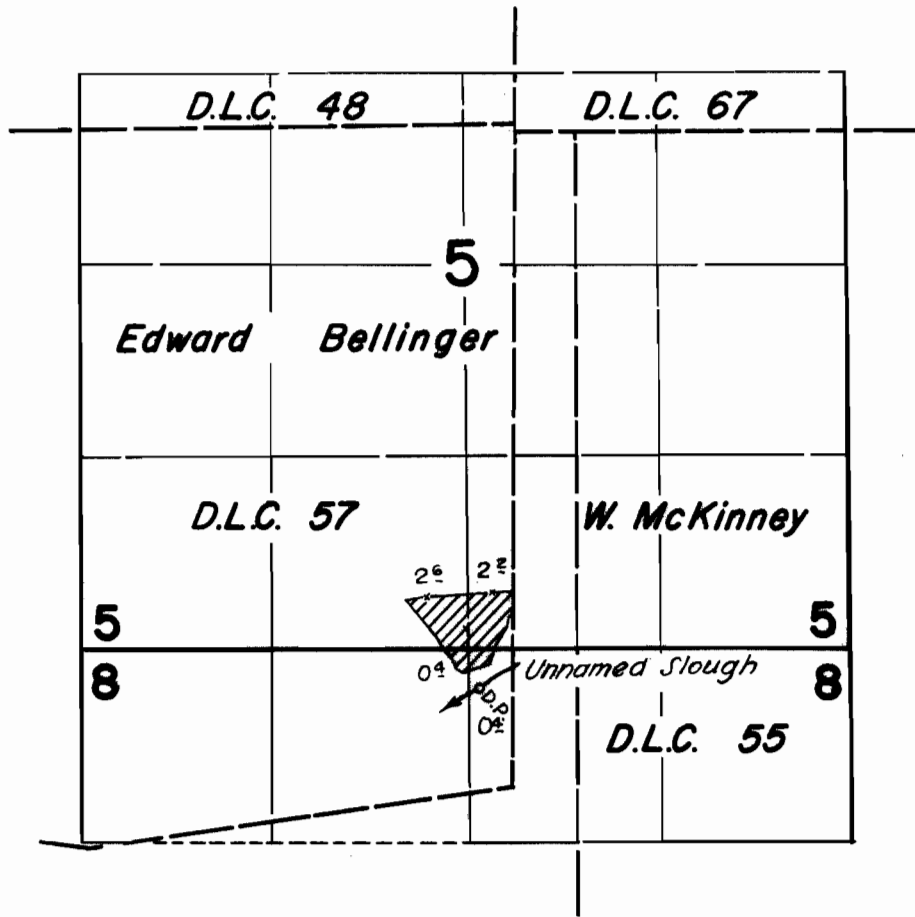

## FINAL PROOF SURVEY UNDER

Application No. 32934... Permit No. 26027.  
IN NAME OF

ETHEL L. GULVIN

Surveyed June 22, 1962, by *R. Jackson*