


T.2N.R.27E.W.M.

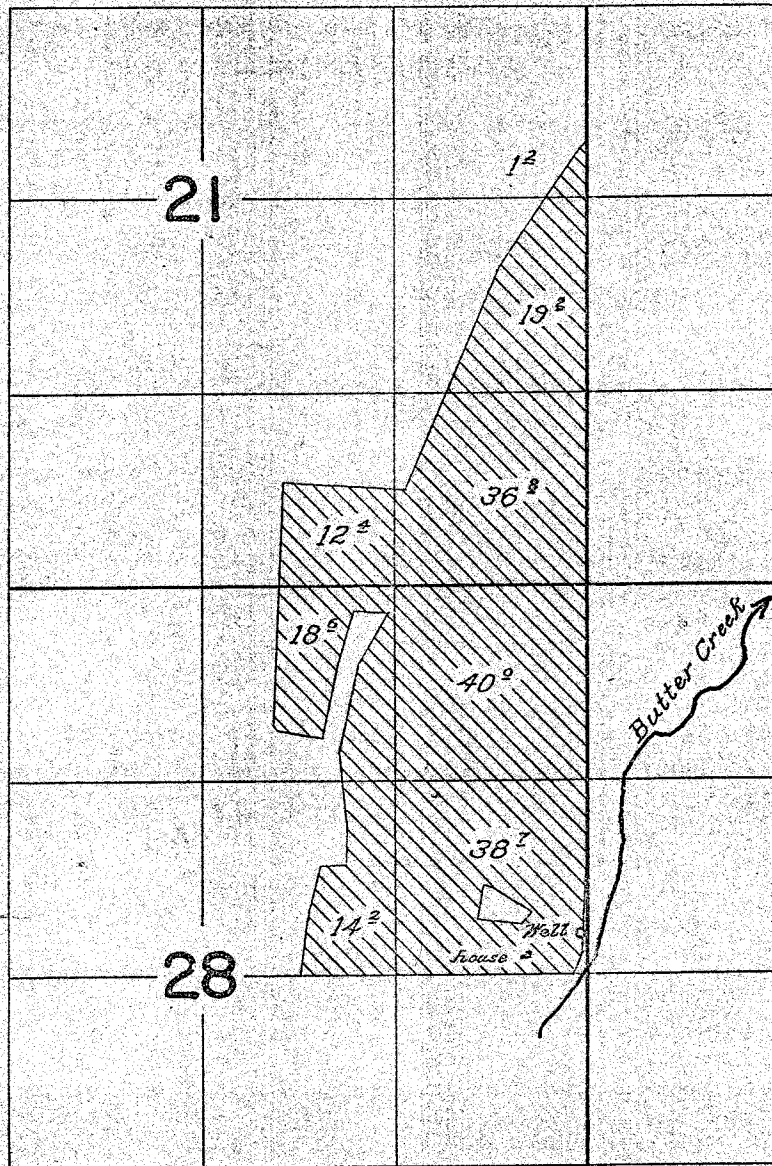

FINAL PROOF SURVEY UNDER

Application No. *U-496* Permit No. *U-450*
IN NAME OF

Tucker Echo Ranch

Surveyed *October 1, 1962*, by *Thomas R. Lauer*