


T.3N.R.27E.W.M.

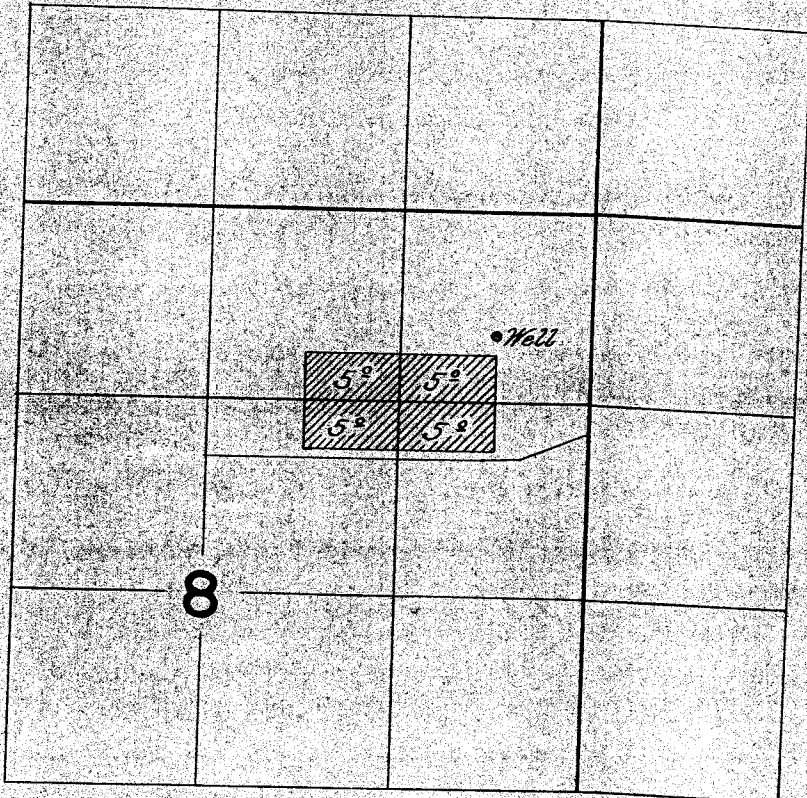

FINAL PROOF SURVEY UNDER

Application No. *U-580* Permit No. *U-530*
IN NAME OF

Leota Nell Martin

Surveyed *Sept. 26, 1962*, by *Thomas P. Lauer*