


T.4N.R.27E.W.M.

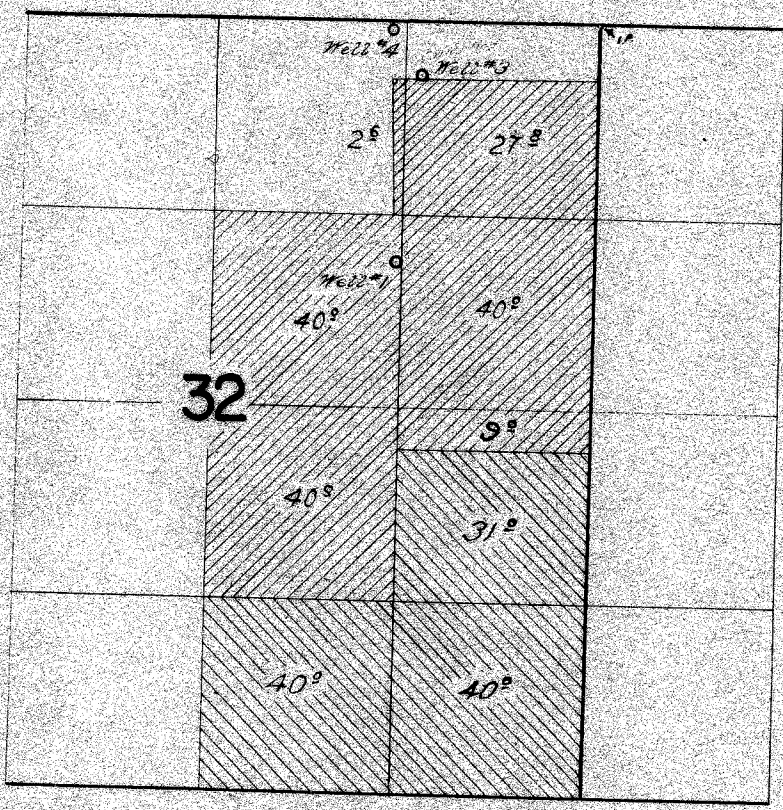

Supplemental



Primary

FINAL PROOF SURVEY UNDER

Application No. G-1777 Permit No. G-1625
IN NAME OF

Roy Gail + Georgia Bell Holzappel

Surveyed Sept. 27 1962, by *Thomas R. Lauer*