


T.1N.R.3E.W.M.

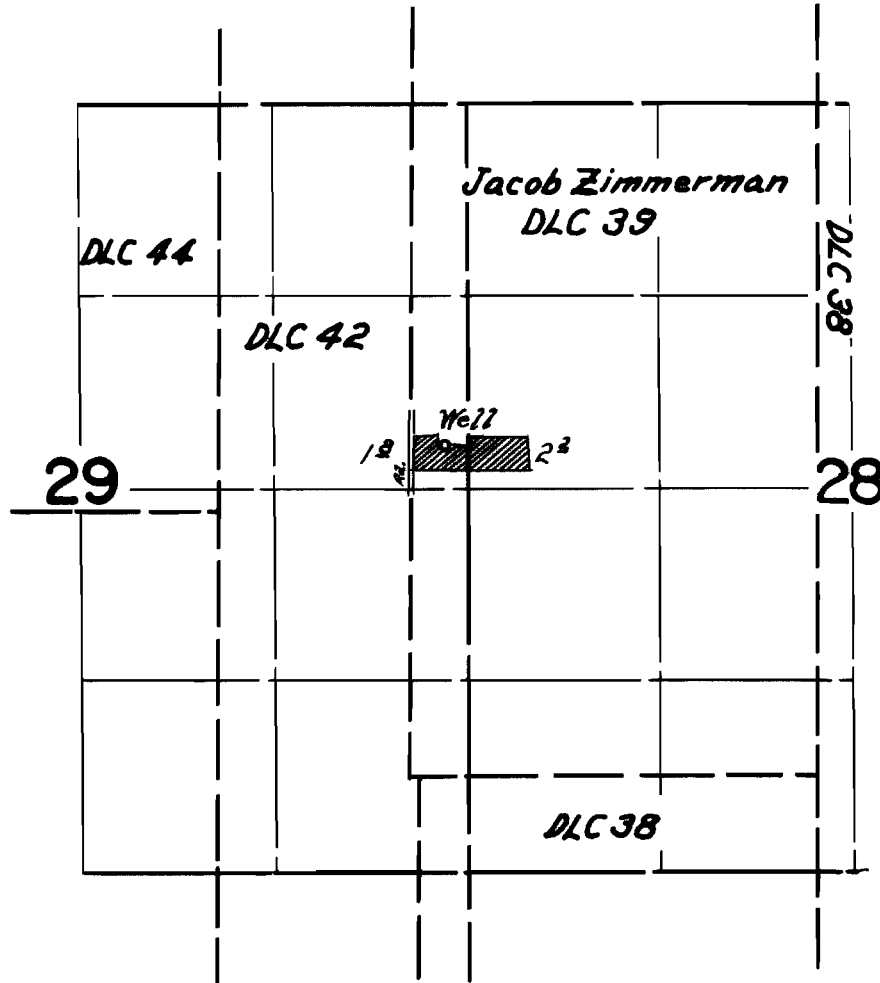

FINAL PROOF SURVEY UNDER

Application No. *G-976* Permit No. *G-844*
IN NAME OF

James A. & Marion C. Dunbar

Surveyed *June 29 1962*, by *Thomas F. Lauer*