


T.1S.R.4E.W.M.

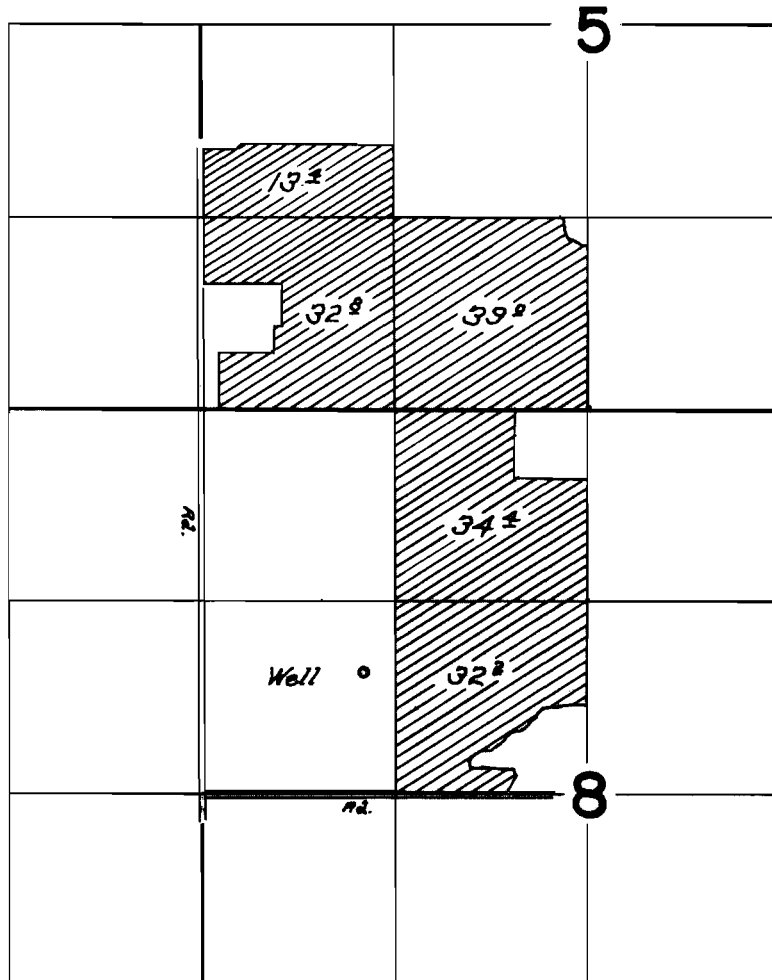

FINAL PROOF SURVEY
UNDER

Application No. *G-1479* Permit No. *G-1356*
IN NAME OF

Arthur S. Burns

Surveyed *June 28 1962*, by *Thomas R. Lauer*