


T.10S. R.7W.W.M.

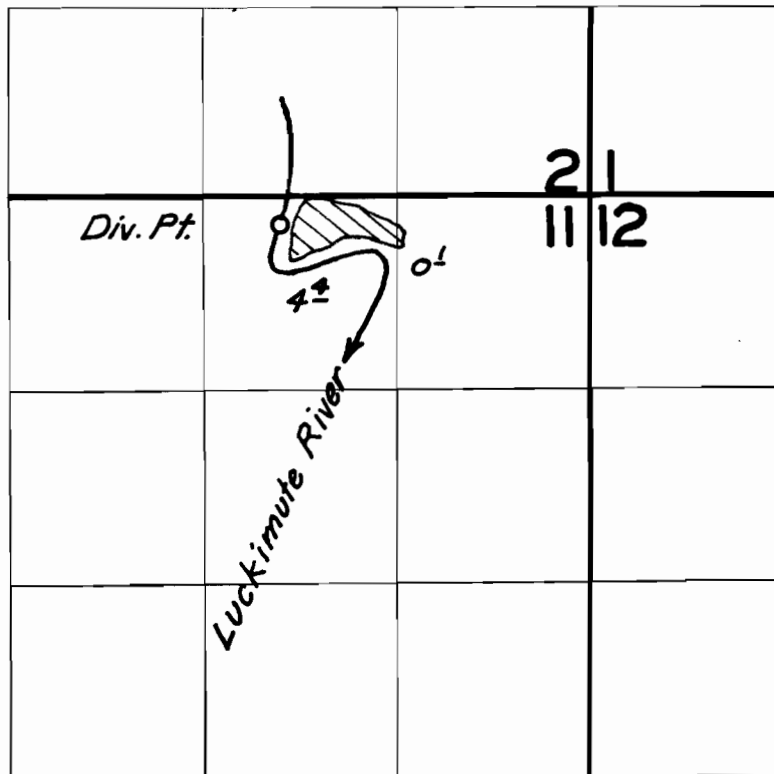

**FINAL PROOF SURVEY**  
UNDER

Application No. *31632* Permit No. *24934*  
IN NAME OF

*Bill H. and Frieda P. Whitmore*

Surveyed *20 June, 1962*, by *Carl R. Baker*