


T.7S. R.5W.W.M.

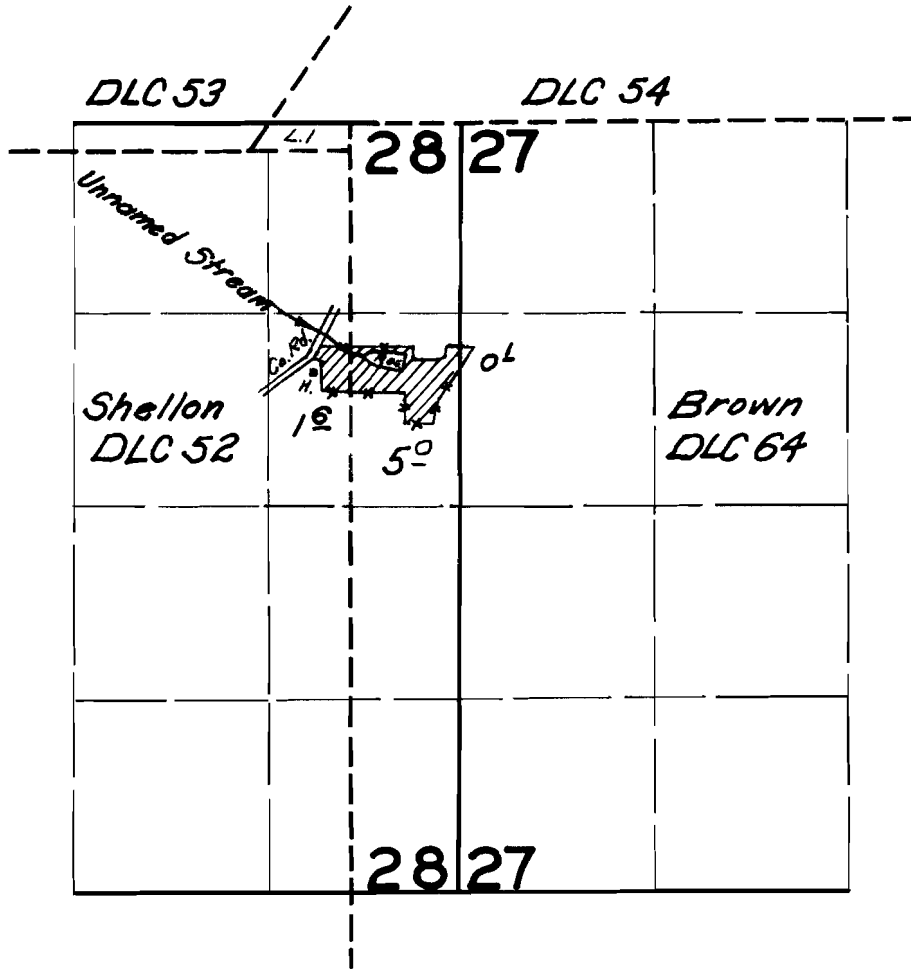

FINAL PROOF SURVEY
UNDER

Application No. *R-32338* 32337 Permit No. *R-2145* 25530
IN NAME OF

Melvin Olfert

Surveyed *29 Aug.* 1962, by *Carl R. Baker*