


T. 8S. R. 6W.W.M.

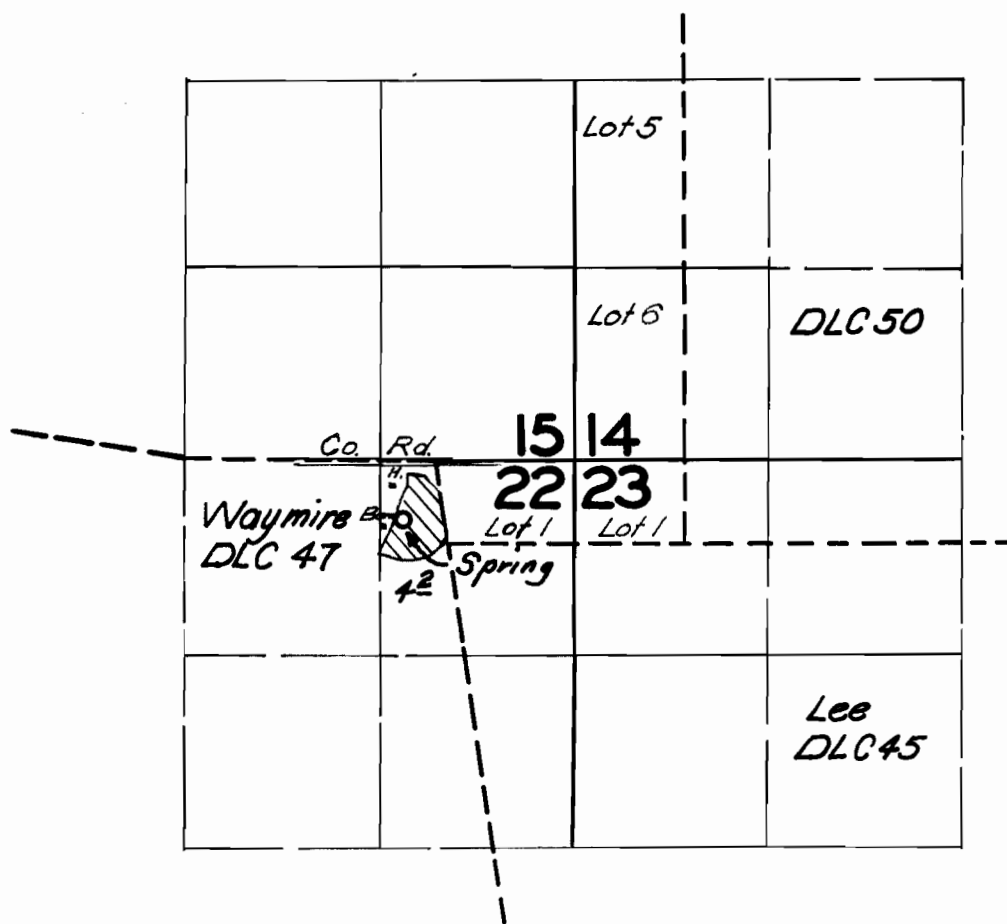

FINAL PROOF SURVEY
UNDER

Application No. 32470 Permit No. 25638
IN NAME OF

William Rancore

Surveyed Aug. 31, 1962, by Carl R. Baker