


T. 2 S. R. 16 E. W. M.

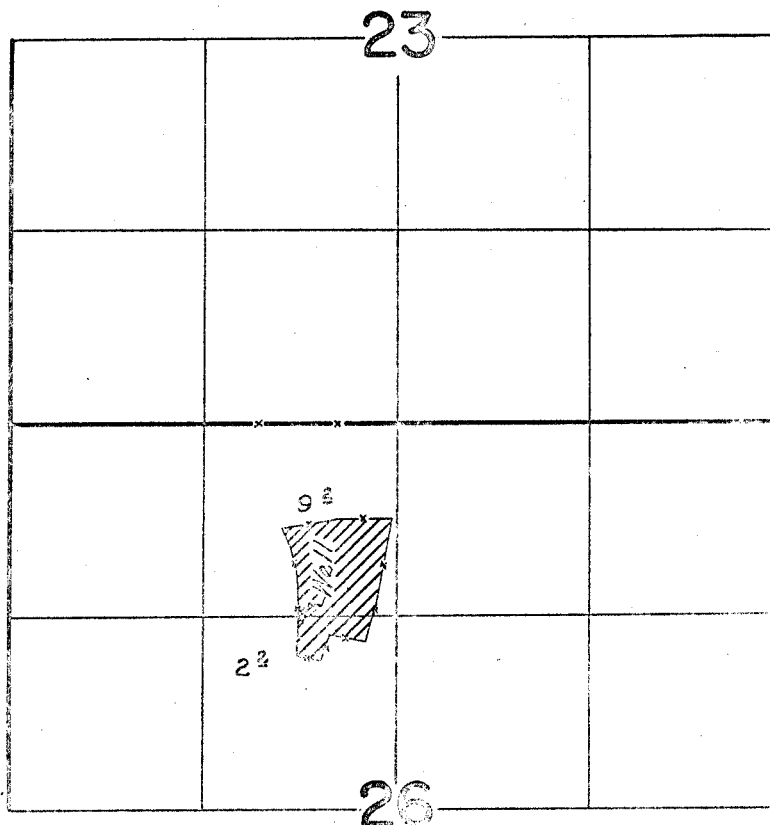

FINAL PROOF SURVEY
UNDER

Application No. G-1040. Permit No. G-92.7.
IN NAME OF

.....WALLACE MAY.....

Surveyed Sept 25 1962, by C.R. Baker.....