


T. 3 N. R. 18 E. W.M.

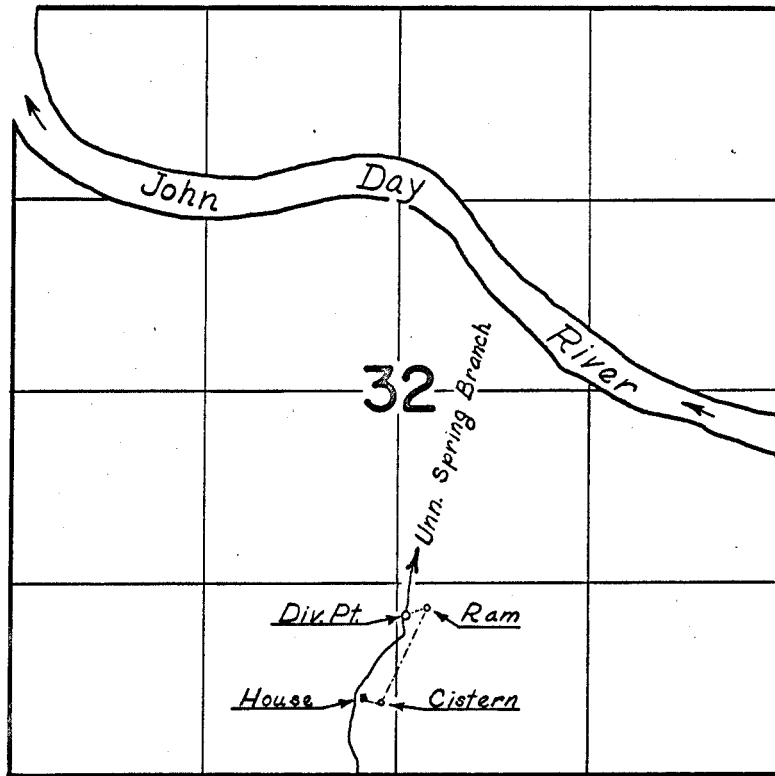

FINAL PROOF SURVEY
UNDER

Application No. 27007... Permit No. 21211....
IN NAME OF

.....GEORGE L. FOX.....

Surveyed Sept 27, 1962, by C.R. Baker.....