


5
T. 4 S. R. 17 E.W.M.

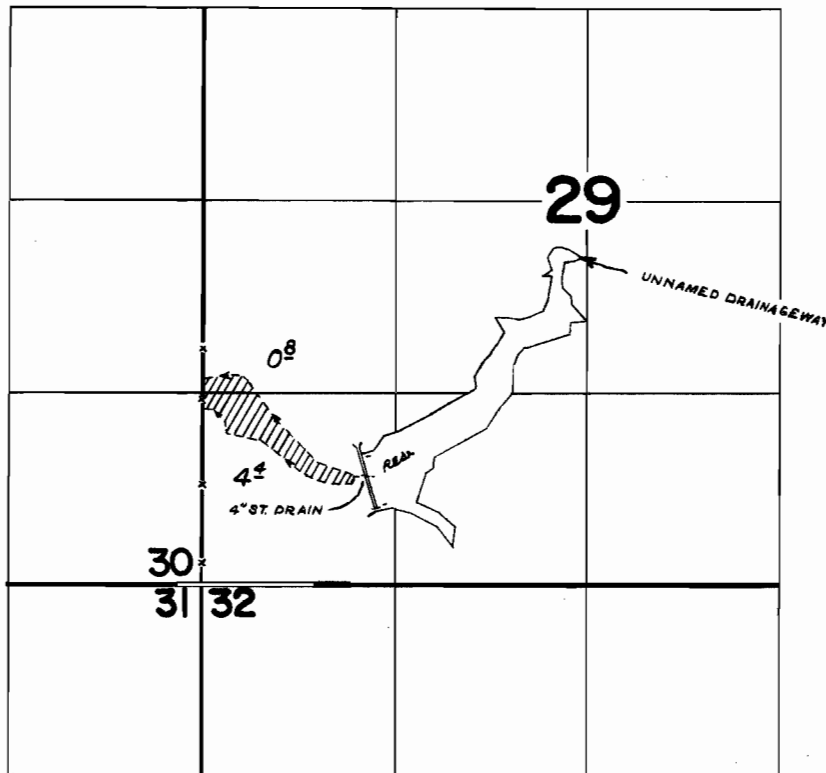

FINAL PROOF SURVEY
UNDER

R-29497 R-1731
Application No. ~~29498~~ Permit No. ~~23491~~
IN NAME OF

ESTATE OF J. M. WILSON

Surveyed Sept. 25 1962, by C. R. Baker