


T. 4 S. R. 17 E. W. M.

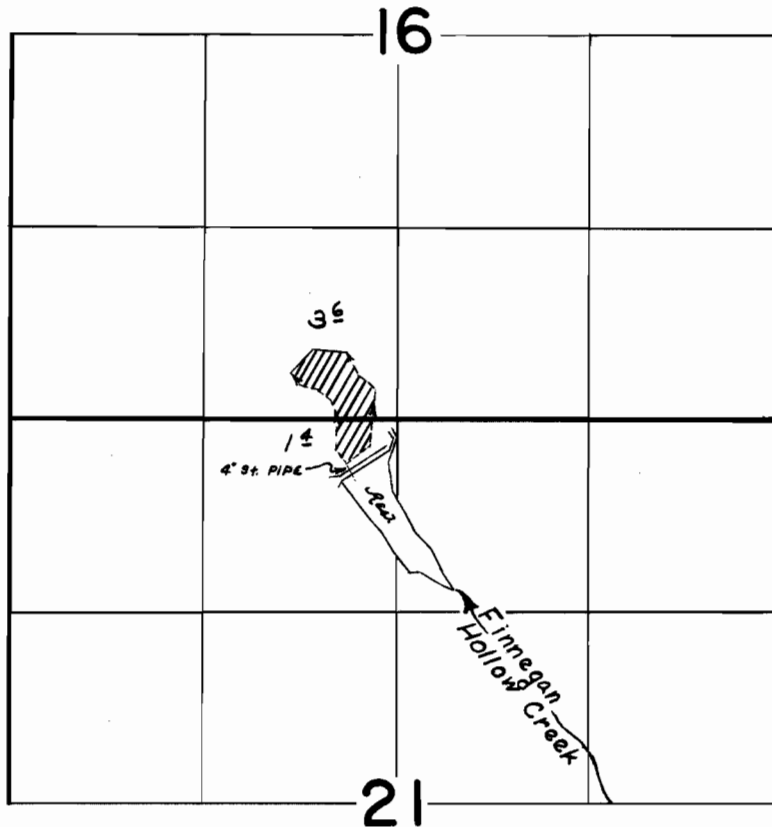

FINAL PROOF SURVEY
UNDER

R-29499 *R-1732*
Application No. *29500* Permit No. *23492*
IN NAME OF

ESTATE OF J. M. WILSON

Surveyed *Sept 25 1962*, by *C.R. Baker*