


T.6N.R.34E.W.M.

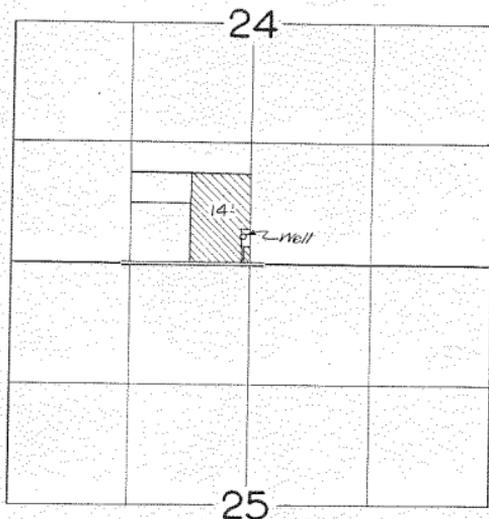

FINAL PROOF SURVEY  
UNDER

Application No. G-918 . Permit No. G-828  
IN NAME OF

J. L. RALEY

Surveyed April 26 1962. by

*L. Johnson*