


T.6N.R.34E.W.M.

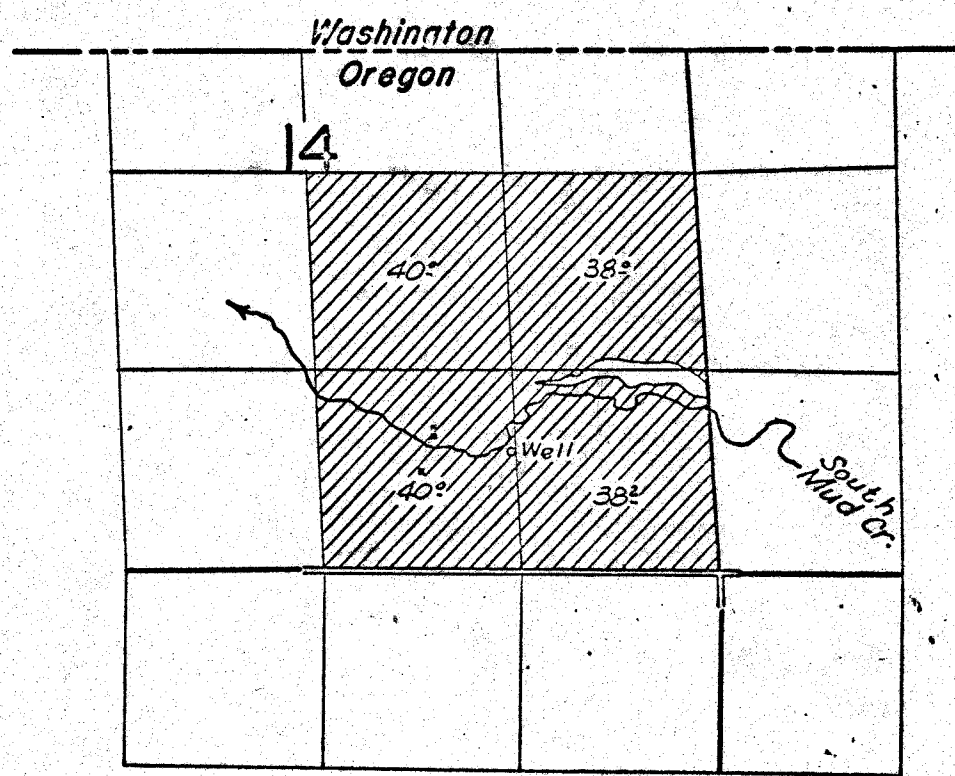

FINAL PROOF SURVEY
UNDER

Application No. G-1346 Permit No. G-1230
IN NAME OF

S. C. WEATHERMAN

Surveyed April 26 1962, by *Alperon*