


# T.6N.R.34E.W.M.

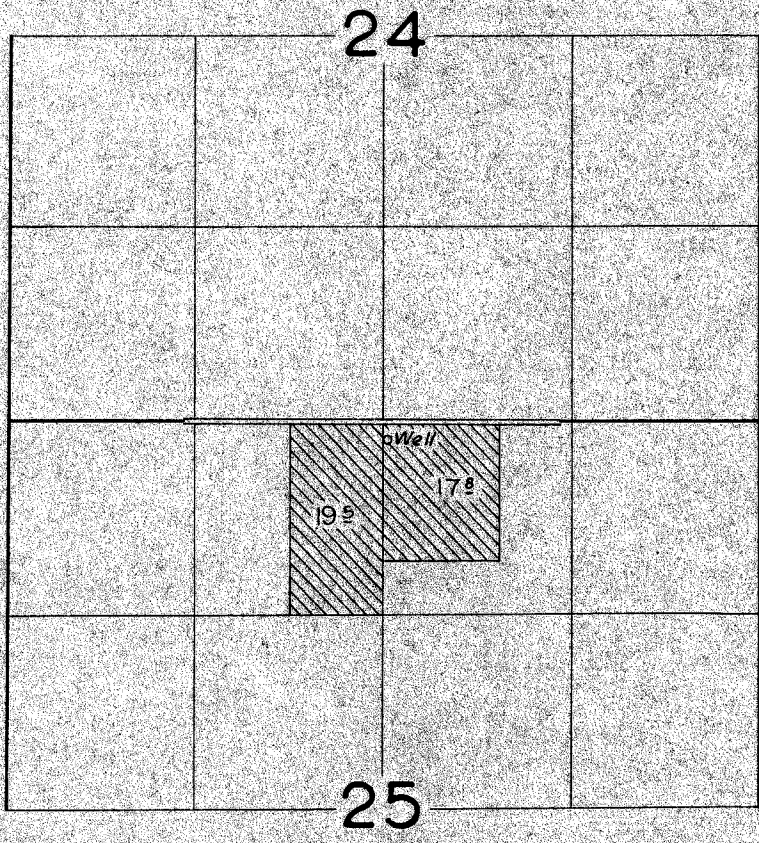

## FINAL PROOF SURVEY UNDER

Application No. **G-1382** Permit No. **G-1272**  
IN NAME OF

**ROBERT G. SCHUBERT**

Surveyed April 26 1962, by *R. H. Johnson*