


# T. 1 S. R. 12 E. W.M.

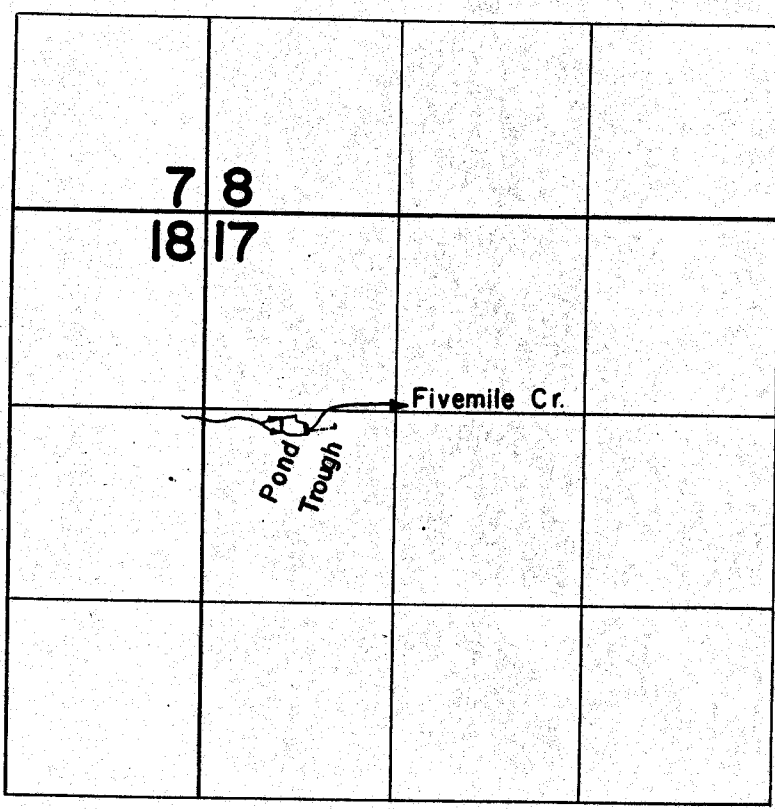

## FINAL PROOF SURVEY UNDER

R-19513                      R-772  
Application No. 19514    Permit No. 15108  
IN NAME OF

**RAY F. KELLY**

Surveyed June 13, 1962, by *P. W. Jelovisek*